

MISSISSIPPI DEPARTMENT OF NATURAL RESOURCES

Bureau of Land and Water Resources

P.O. Box 10631

Jackson, Mississippi 39209

WATER WELL DRILLERS LOG

COUNTY WELL LOCATED Perry	
WELL NUMBER R	CODED
DATE WELL COMPLETED 2009 May 9 - 1987	

PERMIT NUMBER
NAME OF DRILLING FIRM Cochran Water Well Service

NAME & MAILING ADDRESS OF LANDOWNER Dick Graham			
Rt 12 Hattiesburg			
WELL LOCATION:	SEC 31	TOWNSHIP 18	RANGE 10 E
DISTANCE 6 Miles	DIRECTION N^WE	NEAREST TOWN Wiggins	
OTHER LANDMARK			
WELL PURPOSE <input checked="" type="radio"/> Home Irrigation, <input type="radio"/> Municipal, <input type="radio"/> Industrial, <input type="radio"/> Fish Pond, etc.			

PUMP DATA		
PUMP TYPE (Circle One): Submersible, Turbine, <input checked="" type="radio"/> Jet, <input type="radio"/> Flowing Well, Other (Describe)		
POWER TYPE (Circle One): <input checked="" type="radio"/> Electric, <input type="radio"/> Tractor, <input type="radio"/> Diesel, <input type="radio"/> Gasoline, <input type="radio"/> Butane, Other (Describe)		
Pump Capacity (GPM) 6	No. of Stages 2	Setting Depth 105 FT.
PUMP TEST Well yielded 6 GPM with a drawdown of _____ ft. after _____ hours of pumping		

WELL DATA		
Well Depth 130'	Casing Diameter (In.) 2	Casing Length (Ft.) 120
Type of Casing PVC	Hole Depth 130'	Depth to Static Water Level 95'
TYPE OF COMPLETION: (Circle One or More): <input checked="" type="radio"/> Gravel Packed, <input type="radio"/> Underreamed, <input type="radio"/> Telescoped, <input type="radio"/> Natural Development, <input type="radio"/> Open Hole, <input type="radio"/> Other (Describe)		
Top of Lap Pipe or Reduction in Casing FEET IF TELESCOPED OR MORE THAN ONE SCREEN: USE BACK PAGE		

LOG DATA	
TYPE OF LOG RUN (Circle One): <input checked="" type="radio"/> No Log Run, <input type="radio"/> Electric, <input type="radio"/> Gamma Ray, <input type="radio"/> Density, <input type="radio"/> Sonic, <input type="radio"/> Neutron, Other (Describe)	
Name of Organization Running Log	

SCREEN DATA		
Diameter - Inches 2	Length - Feet 10	Slot Size - Inches 10
Screen Type PVC	Depth to Bottom - Feet 130	


GEOLOGIC DATA (Office Use Only)			
Surface Elev.	Geologic Unit	Unit Thickness	Depth to Top
Subs. SWL	Date	Analysis	Aquifer Test

Driller's Remarks	

DESCRIPTION OF FORMATIONS ENCOUNTERED	FROM	TO	FORMATIONS (Continued)	FROM	TO
Top soil	0	1	RECEIVED		
Red clay	1	4			
Red sand	4	21			
Gray clay	21	38			
Blue gray sand	38	71			
	71	130			
			JUN 08 1987		
			Department of Natural Resources Bureau of Land & Water Resources		
IF MORE SPACE IS NEEDED, USE BACK					

If well telescopes please sketch and show depths.

GROUND LEVEL

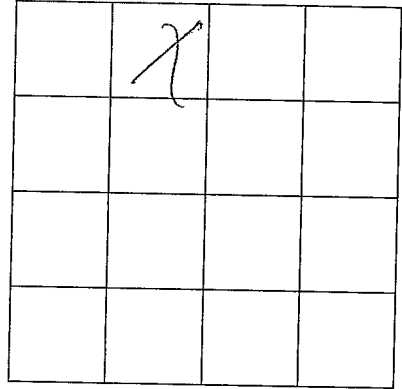

SECTION 31

Please indicate well location X.

ADDITIONAL INFORMATION

If more than one screen,
show location of each on sketch.