

Perry
 S6
 2/23/78

MISSISSIPPI
 BOARD OF WATER COMMISSIONERS
 416 North State Street
 Jackson, Mississippi 39201

CODED

WATER WELL DRILLERS LOG

2/23/78 1978 date well completed
 River Drilling Service firm name
 Perry county well located

LANDOWNER: Shell Oil Co.
 USA 25-10
 South Deep Creek
 (mailing address)

WELL LOCATION:
 sec. 25 T 1 N R 9 E
 2.150' N & 1.500' W of SE cor. Bendler
 (distance) miles (direction) of (nearest town)

WELL PURPOSE: Oil Well Supply
 (home, irrigation, municipal, industrial)

- WELL COMPLETION DATA:
- (1) diameter (inches) 3"
 - (2) total depth (feet) 714'
 - (3) static water level (feet) 90' below top of ground.
 - (4) casing Steel 694' (material) (depth)
 3" (size) If telescope see back.
 - (5) screen 42' 652' (length) (depth to top)
 3" Rectorated Pipe (size) (material)
 - (6) pump — 90 (HP) (yield gpm).
 AC (type power)
 - (7) electric log NO (yes or no)
 - (organization running log)
 - (8) how well bottom plugged. Orange
 Peel

description of formations encountered	from	to
Sand & Gravel	21	63
Chalk	63	210
Stratified	210	252
Chalk	252	294
Stratified in place	294	378
Chalk	378	609
Stratified	609	651
Sand	651	693
Red Gravel	693	700
Stratified	700	714


DRILLERS REMARKS:
 Randy Laird

RECEIVED
 MAR 10 1978

MISS. BD. OF WATER COMMISSIONERS

If well telescopes please sketch and show depths.

GROUND LEVEL

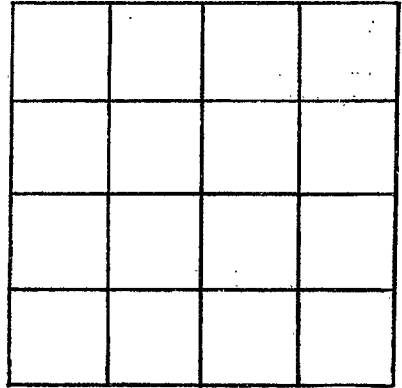

SECTION _____

Please indicate well location X.

ADDITIONAL INFORMATION

If more than one screen, show locations of each on sketch.