STATE WELL REPORT					
County: Perry Permit #:	D Mississippi Departa Office of La Jacksa ((60 be prepared by the rithin 30 days of con ion a water well)	Part 1 priller's Log ment of Environmental Quality and and Water Resources P.O. Box 2309 on, MS 39225-2309 601)961-5555 1)961-5228 (fax) license holder responsible for the mpletion of drilling of the well of Well or Bore Latitude: <u>30.9823940</u> Lor	elev 255 he work and filed with or borehole. whole Location ngitude: <u>-88.928</u>	RECEIVED 03-09-2022 th the BY OLWF 4570	
Mailing Address: 9 print Coole Wiggins Ms City State Telephone No. ()	39577 Zip Code	Method of Lat/Long (check one USGS quad, Hand-held G ¼¼_ Sec Miles0 (Distance) (Direction)	PS <u>//</u> , Survey-grade	e GPS R	
	Well / R	orehole Data			
	vater used for drillin ne used in drilling a un Electric Gamm Well Geotechni ic Survey Other (ng: <u>Creek</u> nd development: <u>Granula</u> na Ray Density Sonic Neutro	r on Other: Ground Source Heat P		
	ation: Valve [above or 🗹 belo (check one) Steel tape 🗹 Electric depth of: <u>10</u> f asing diameter: <u>4</u> creen diameter: <u>2</u> Setting depth: e): Gravel packed 🗹	Other (describe) ow] land surface Date measur tape Air line Other (describe) eet Type of grout (check one) eet Type of grout (check one)	ed: 02/28/202): Neat Cement Bent casing: PVC screen: PVC 345 445 Natural Developm	onite Mix feet	
Top of lap pipe or reduction in casing:feet If telescoped or more than one screen, describe on next page					
is consequent in more man one servery accentee on new page					

County:	Perry
-	
Permit #:	




For Office Use Only:

S11

<u>Description of formations encountered must be provided for all wells</u> and boreholes, unless specifically exempted by regulations

Well #: _

The sketch below only required for water wells

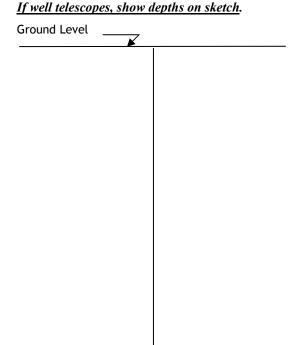

Description of Formations Encountered	From (depth)	To (depth)
Brown dirt	Ground level	12
Sand	12	63
Blue clay	63	380
Sand	380	445

If more than one screen, show location of each on sketch

Sketch the property layout and include the following:

1) the well location

2) any permanent structures on the property that may aid in locating the well

3) any roads, power lines, or other items that may aid in locating the property and the well

4) north arrow



Landowner Name: Floyd odum

I HEREBY CERTIFY that the well/borehole was drilled, constructed, and completed in accordance with all applicable requirements of the Mississippi Department of Environmental Quality and the Mississippi Department of Health regulations, if applicable, and state laws.

Scott Boone 6262 03/08/2022 Print Name of Responsible Licensee and License No. Date



Scott Boone Signature of Licensee