

MISSISSIPPI DEPARTMENT OF NATURAL RESOURCES

Bureau of Land and Water Resources

Southport Mall

P.O. Box 10631

Jackson, Mississippi 39209

WATER WELL DRILLERS LOG

FERRY  
S 200  
3/3/81

March 3  
date well completed

1981

firm name

county well located

Parnell Anderson Perry

LANDOWNER: George Omeal  
Star Rents 1, Box  
J Wiggins  
Leaf, MS 39577  
(mailing address)

description of formations encountered

from

to

<u>Top soil</u>	<u>0</u>	<u>3</u>
<u>Clay</u>	<u>3</u>	<u>26</u>
<u>Sand</u>	<u>26</u>	<u>32</u>
<u>Clay</u>	<u>32</u>	<u>51</u>
<u>Sand</u>	<u>51</u>	<u>80</u>

WELL LOCATION:

sec. 29 T 1 N R 9 E  
24 miles E of Wiggins  
(distance) (direction) (nearest town)

WELL PURPOSE: Home  
(home, irrigation, municipal, industrial)

WELL COMPLETION DATA:

- (1) diameter (inches) 2"
- (2) total depth (feet) 80'
- (3) static water level (feet) 45' below above top of ground.
- (4) casing PVC 75'  
(material) (depth)
- (size) if telescope see back.
- (5) screen 5' 75'  
(length) (depth to top)
- 2" PVC  
(size) (material)
- (6) pump 1 9  
(HP) (yield gpm)
- Electric  
(type power)
- (7) electric log NO  
(yes or no)

(organization running log)

(8) how well bottom plugged yes

DRILLERS REMARKS:


DEPT. OF NATURAL RESOURCES  
BUREAU OF LAND & WATER RESOURCES

MAY 18 1981

RECEIVED

If well telescopes please sketch and show depths.

GROUND LEVEL

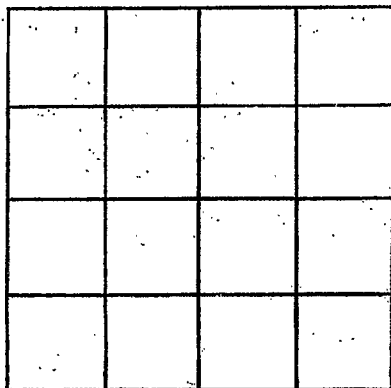

SECTION \_\_\_\_\_

Please indicate well location X.

ADDITIONAL INFORMATION

249 15  
P

If more than one screen, show locations of each on sketch.