

MISSISSIPPI DEPARTMENT OF NATURAL RESOURCES

Bureau of Land and Water Resources

Southport Mall

P.O. Box 10631

Jackson, Mississippi 39209

WATER WELL DRILLERS LOG

Berry

2003

1-28 19 82 *Fryeagle Mines* *Berry*
 date well completed firm name county well located

LANDOWNER: *Albinna Miller*
Millers

Mc Lane, Miss
 (mailing address)

description of formations encountered	from	to
<i>Clay</i>	0	20
<i>South Clay</i>	20	48
<i>Shales of Clay Sand</i>	48	60
<i>Clay</i>	60	70
<i>Clay & Sand</i>	70	90

WELL LOCATION:
 sec. *1* T. *1* N. R. *9* E
2 miles *W* of *Mc Lane*
 (distance) (direction) (nearest town)

WELL PURPOSE:
 (home, irrigation, municipal, industrial)

WELL COMPLETION DATA:

- (1) diameter (inches) 2
- (2) total depth (feet) 90
- (3) static water level (feet) 60 below above
 top of ground.
- (4) casing PVC 80
 (material) (depth)
 (size) if telescope see back.
- (5) screen 10' PVC
 (length) (depth to top)
2" (size) (material)
- (6) pump 3/4 10
 (HP) (yield gpm)
Clear Jet (type power)
- (7) electric log no
 (yes or no)
 (organization running log)
- (8) how well bottom plugged PVC
with cement

DRILLERS REMARKS: *John*
Well Produced
~~...~~


DEPT. OF NATURAL RESOURCES
 BUREAU OF LAND & WATER RESOURCES

APR 6 1982

RECEIVED

If well telescopes please sketch and show depths.

GROUND LEVEL

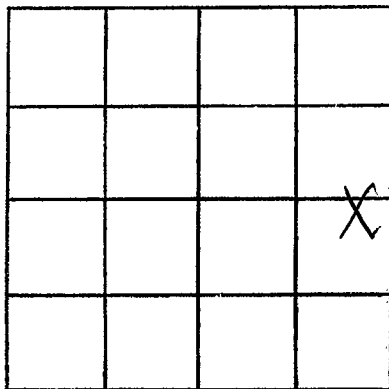

SECTION 1

Please indicate well location X.

ADDITIONAL INFORMATION

If more than one screen,
show locations of each on sketch.