

MISSISSIPPI DEPARTMENT OF NATURAL RESOURCES

Bureau of Land and Water Resources

Southport Mall

P.O. Box 10631

Jackson, Mississippi 39209

WATER WELL DRILLERS LOG

PERRY  
S 2005

7-8 1985 date well completed      Frank Pucci firm name      Perry county well located

LANDOWNER:	description of formations encountered	from	to
Roland Byland	Top Soil	0	2
(mailing address)	Red clay	2	25
WELL LOCATION:	Fin Sand	25	45
sec. 32 T. 1 S. R. 9 DEEP CREEK COURSE LAND	Course Land	45	72
1/2 miles W of SCHOOL			
(distance) (direction) (nearest town)			
WELL PURPOSE: HOME			
(home, irrigation, municipal, industrial)			
WELL COMPLETION DATA:			
(1) diameter (inches) 2"			
(2) total depth (feet) 72'			
(3) static water level (feet) 50' below top of ground.			
(4) casing PVC 67' (material) (depth)			
(size) If telescope see back.			
(5) screen 5' 67' (length) (depth to top)			
2" PVC (size) (material)			
(6) pump 1 HP 7 (type power) (yield gpm)			
(7) electric log no (yes or no)			
(organization running log)			
(8) how well bottom plugged BWV			

RECEIVED


NOV 19 1985

Department of Natural Resources  
Bureau of Land & Water Resources

DRILLERS REMARKS:

If well telescopes please sketch and show depths.

GROUND LEVEL

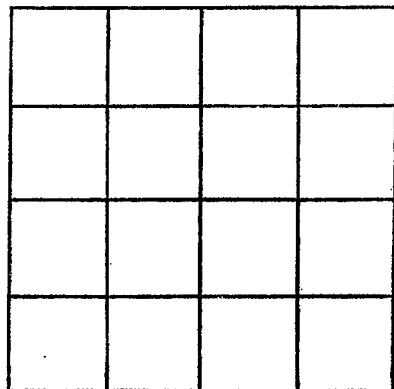

SECTION \_\_\_\_\_

Please indicate well location X.

ADDITIONAL INFORMATION

If more than one screen,  
show locations of each on sketch.