

PIKE
A
10/29/74

MISSISSIPPI
BOARD OF WATER COMMISSIONERS CODED
416 North State Street
Jackson, Mississippi 39201

WATER WELL DRILLERS LOG

Oct 24 1974 Chester Lewis Pike
date well completed firm name county well located

LANDOWNER: Charity
Baptist Church
Summit Miss.
(mailing address)

description of formations encountered	from	to
Clay	0	16
Loess	16	40
Red sand	40	86
Red gravel sand	86	96

WELL LOCATION:
sec. 27 T. 4 N. R. 7 E.
3/4 miles W of Summit
(distance) (direction) (nearest town)

WELL PURPOSE: Farm - Church
(home, irrigation, municipal, industrial)

- WELL COMPLETION DATA:
- (1) diameter (inches) 4
 - (2) total depth (feet) 96
 - (3) static water level (feet) 63 below top of ground.
 - (4) casing Plast Bottom
(material) (depth)
(size) if telescope see back.
 - (5) screen 6' 90
(length) (depth to top)
Plast
(size) (material)
 - (6) pump 1/2 sub 15
(HP) (yield gpm)
Electric
(type power)
 - (7) electric log no
(yes or no)

CODED


(8) how well bottom plugged
woodchump log

DRILLERS REMARKS:
new location

NOV 18 1974
MISS. BD. OF WATER COMMISSIONERS

If well telescopes please sketch and show depths.

GROUND LEVEL

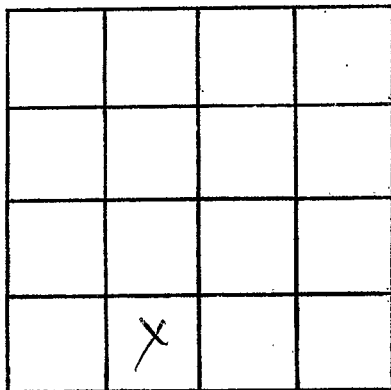

SECTION 27

Please indicate well location X.

ADDITIONAL INFORMATION

If more than one screen, show locations of each on sketch.