

PIKE

MISSISSIPPI BOARD OF WATER COMMISSIONERS

A6

CODED

7-18-61

CODED

WATER WELL DRILLERS LOG

A

Date: 7-18, 1961, Driller: Chester Reeves County: Pike  
(Name)

(1) Owner of Land:

Old House  
(Name)

RFD Summit  
(Address)

(2) Location:

1/4, 1/4, Sec. 17 T4 R1

4 miles west Summit  
(distance) (direction) (Nearest Town)

(3) Topography:

Hilly  
(Hilly) (Flat) (Level)

(4) Purpose of Well:

Domestic  
(Domestic Irrigation  
Municipal, Industrial, Other)

Description & Color of Materials  
Sand, Clay, Red Clay, Shell, etc.

Thick-  
ness  
Feet

yellow clay  
Red soupy sand  
white chalk  
FINE Sand  
Coarse white  
Sand

25  
70  
35  
5  
17  
152

CODED

Information upon completion of well:

(1) Diameter: 2 inches.

(2) Total Depth: 152 feet.

(3) Water Level: 70 feet below top of ground.

(4) Cased to: Bottom, Size 2"

(5) Screen: Size 1 1/4, Length 5'

(6) Were any formations sealed against pollution?

yes, no.


If YES depth of formation

Why

Drillers Remarks: new house

No Previous well

CODED

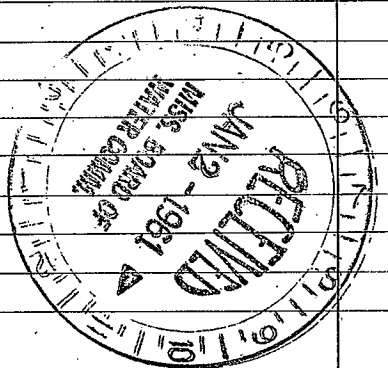

(Use Back Side)

DEPARTMENT OF CHEMISTRY

RESEARCH REPORT

BY

DATE