

PIKE
A 13

MISSISSIPPI BOARD OF WATER COMMISSIONERS

CODED

10-14-63

CODED WATER WELL DRILLERS LOG

Date: 10-14, 1963, Driller: Chester Reeves County, Rebo
(Name)

(1) Owner of Land Charles Dawson
(Name)
Summit
(Address)

Description & Color of Materials Sand, Clay, Red Clay, Shell, etc.	Thick- ness Feet	Dep Feet
<u>clay</u>	<u>8-8</u>	
<u>sand</u>	<u>27-35</u>	
<u>gravel sand</u>	<u>5-40</u>	

(2) Location: 1/4, 1/4, Sec. 36 T 7 R 7,
1 miles S.E. of Summit
(distance) (direction) (Nearest Town)

(3) Topography: Flat
(Hilly) (Flat) (Level)


(4) Purpose of Well: Domestic
(Domestic Irrigation
Municipal, Industrial, Other)

CODED

CODED

Information upon completion of well:

- (1) Diameter 4 inches.
- (2) Total Depth 40 feet.
- (3) Water Level 10 feet below top of ground.
- (4) Cased to bottom Size 4"
- (5) Screen: Size 4", Length 4'
- (6) Were any formations sealed against pollution?
yes, no.

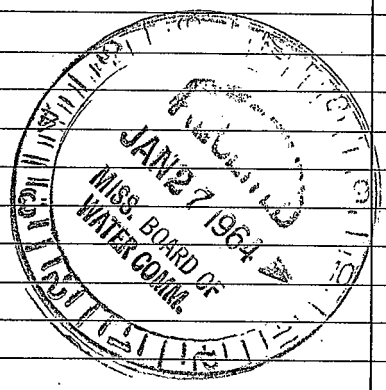

If YES depth of formation _____

Why _____

Drillers Remarks: red well
sanded

REEVES WELL & PUMP CO.
P. O. BOX 71 -- PHONE 684-1451
MCCOMB, MISS.

(Use Back Side)

Well No.

100

101

102

119