

PIKE
A 14

MISSISSIPPI BOARD OF WATER COMMISSIONERS

CODED

CODED
CODED

10-24-63

WATER WELL DRILLERS LOG

Date: 10-24, 1963, Driller: Chester Reeves County, Pike
(Name)

(1) Owner of Land:	Description & Color of Materials Sand, Clay, Red Clay, Shell, etc.	Thick- ness Feet	Dep- th Feet
(Name) <u>Lynn Butler</u> (Address) <u>RFD, Summit</u>	<u>Red clay</u>	<u>10-10</u>	
(2) Location: <u>1/4</u> , <u>1/4</u> , Sec. <u>31 T4R7</u> , <u>5</u> miles <u>west</u> of <u>Smithland</u> , (distance) (direction) (Nearest Town)	<u>yellow sand</u>	<u>85-95</u>	
(3) Topography: <u>Hilly</u> (Hilly) (Flat) (Level)	<u>sand & gravel</u>		
(4) Purpose of Well: <u>Domestic</u> (Domestic Irrigation Municipal, Industrial, Other)	<u>gravel</u>	<u>12-107</u>	


Information upon completion of well:

- (1) Diameter 4 inches.
- (2) Total Depth 107 feet.
- (3) Water Level 80 feet below top of ground.
- (4) Cased to Bottom Size 4
- (5) Screen: Size 4", Length 5'
- (6) Were any formations sealed against pollution?
no

If YES depth of formation _____

Why _____

Drillers Remarks:
New house
Trailer

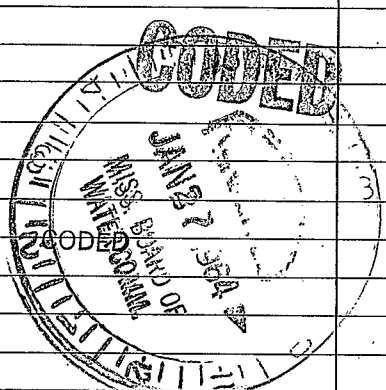

REEVES WELL & PUMP CO.
P. O. BOX 71 - PHONE 664-1451
McCOMB, MISS.

(Use Back Side)

Well No.

THE NATIONAL ARCHIVES
COLLEGE PARK, MARYLAND
20540