

CODED

MISSISSIPPI
BOARD OF WATER COMMISSIONERS
416 North State Street
Jackson, Mississippi 39201

CODED

WATER WELL DRILLERS LOG

<i>Pike</i>
<i>A17</i>
<i>8-68</i>

aug. 8 19*68* *J. T. Carington* *Pike*
 date well completed firm name county well located

LANDOWNER: *Web Holman*

~~*1111*~~
~~*1111*~~
 (mailing address)

description of fomations encountered	from	to
<i>clay</i>	<i>0</i>	<i>15</i>
<i>clay</i>	<i>15</i>	<i>65</i>
<i>Sand</i>	<i>65</i>	<i>120</i>

WELL LOCATION:

sec. *12* T. *4* N R. *7* E

2 miles *North* of *Weymouth*
 (distance) (direction) (nearest town)

CODED

WELL PURPOSE: *Home*
 (home, irrigation, municipal, industrial)

WELL COMPLETION DATA:

(1) diameter (inches) *4"*

(2) total depth (feet) *120'*

(3) static water level (feet) *80'* below above top of ground.

(4) casing *Plastic, 1 1/4"*
 (material) (depth)
4" If telescope see back.
 (size)


(5) screen *6'* *120'*
 (length) (depth to top)
4" *Plastic*
 (size) (material)

(6) pump *1/2* *5*
 (HP) (yield gpm)
P.C.
 (type power)

(7) electric log _____
 (yes or no)

 (organization running log)

(8) how well bottom plugged *wood*

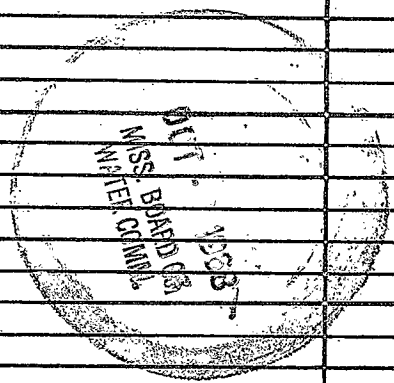

DRILLERS REMARKS:

If well telescopes please sketch and show depths.

GROUND LEVEL

●			

SECTION 12

Please indicate well location X.

ADDITIONAL INFORMATION

If more than one screen, show locations of each on sketch.