

PIKE

MISSISSIPPI BOARD OF WATER COMMISSIONERS

CODED

A 18

7-17-64

CODED WATER WELL DRILLERS LOG

Date: 7-17, 1964, Driller: Christie Lewis County Pike

(Name)

(1) Owner of Land: Leander Naples
(Name)
RFD Summit
(Address)

Description & Color of Materials
Sand, Clay, Red Clay, Shell, etc.

Thick-
ness
Feet

Depth
Feet

Top Clay 15 15
Red sand & gravel 45 60
Chian sand & gravel 15 75

(2) Location: 1/4, 1/4, Sec. 35 T 47 R
1 1/2 miles S.W. of Summit
(distance) (direction) (Nearest Town)

(3) Topography: Hilly
(Hilly) (Flat) (Level)

(4) Purpose of Well: Domestic
(Domestic Irrigation
Municipal, Industrial, Other)

CODED

Information upon completion of well:

(1) Diameter 4 inches.

(2) Total Depth 75 feet.

(3) Water Level 46 feet below top of ground.

(4) Cased to Bottom Size 4"

(5) Screen: Size 4", Length 7'


(6) Were any formations sealed against pollution?
yes, no.

If YES depth of formation _____

Why _____

Drillers Remarks: New House

CODED

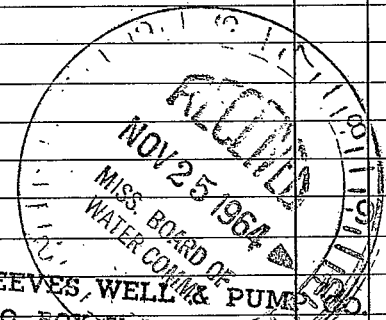

(Use Back Side)

Well No.

