

PIKE

MISSISSIPPI BOARD OF WATER COMMISSIONERS
CODED

A21

6-11-65

WATER WELL DRILLERS LOG

Date: 6/11, 1965, Driller: J. T. Coalington Sec. County Pike
(Name)

(1) Owner of Land: J. R. McLondon
(Name)
Summit, Miss.
(Address)

(2) Location: 1/4, 1/4, Sec. 12 T4 R7
5 miles North of Summit
(distance) (direction) (Nearest Town)

(3) Topography: Hilly
(Hilly) (Flat) (Level)

(4) Purpose of Well: Domestic
(Domestic Irrigation
Municipal, Industrial, Other)

Description & Color of Materials
Sand, Clay, Red Clay, Shell, etc.

Thick-
ness
Feet

Depth
Feet

Sandy Soil 6 6
yellow clay 60 66
Sand 24 90

Information upon completion of well:

(1) Diameter 4 inches.

(2) Total Depth 90 feet.

(3) Water Level 15 feet below top of ground.

(4) Cased to 90', Size 4"

(5) Screen: Size 4", Length 6'

(6) Were any formations sealed against pollution?
no


If YES depth of formation _____

Why _____

Drillers Remarks: _____

COI

CODED

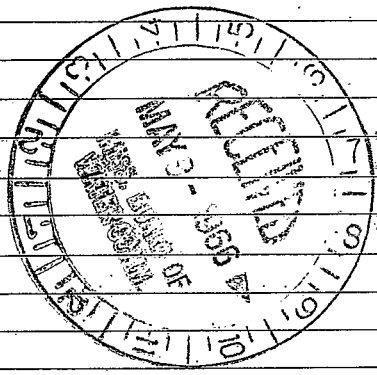

Well No.

(Use Back Side)

