

PIKE
A23

MISSISSIPPI BOARD OF WATER COMMISSIONERS

9-15-65 CODED

WATER WELL DRILLERS LOG CODED

Date: 9-15, 1965, Driller: J.T. Doughty Low County Pike
(Name)

(1) Owner of Land: Mr. Andrew Mir
(Name)
Summit, Miss
(Address)

(2) Location: 1/4, 1/4, Sec. 5 T4R7,
5 miles W/S/W, of Summit,
(distance) (direction) (Nearest Town)

(3) Topography: Hill
(Hilly) (Flat) (Level)

(4) Purpose of Well: Domestic
(Domestic Irrigation
Municipal, Industrial, Other)

Description & Color of Materials Sand, Clay, Red Clay, Shell, etc.	Thick- ness Feet	Depth Feet
Sandy Clay	40	40
SAND & ROCK	40	80
SANDS	24	104

Information upon completion of well:

(1) Diameter 4" inches.

(2) Total Depth 104 feet.

(3) Water Level 80 feet below top of ground.

(4) Cased to 104', Size 4"


(5) Screen: Size 4", Length 6'

(6) Were any formations sealed against pollution?
yes, no.

If YES depth of formation _____

Why _____

Drillers Remarks: _____

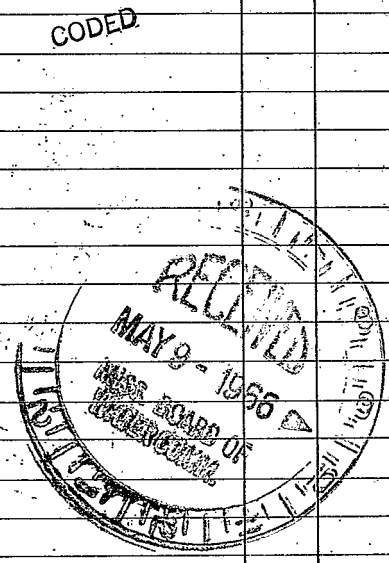

(Use Back Side)

Well No.

1948

1949

1950

1951

1952

1953

1954

1955

1956