

MISSISSIPPI BOARD OF WATER COMMISSIONERS

Pike
A26

CODED

7-27-66 CODED

WATER WELL DRILLERS LOG

Date: 27 July, 1966, Driller: J. T. Covington County Pike
(Name)

(1) Owner of Land: A. R. Caruth
(Name)
Summit
(Address)

(2) Location: NE 1/4, NE 1/4, Sec. 11 T4 R7
5 miles North of Summit
(distance) (direction) (Nearest Town)

(3) Topography: (Hilly) (Flat) (Level)

(4) Purpose of Well: Domestic
(Domestic Irrigation, Municipal, Industrial, Other)

Description & Color of Materials Sand, Clay, Red Clay, Shell, etc.	Thick- ness Feet	Depth Feet
<u>Clay</u>	<u>15</u>	
<u>Sand</u>	<u>10</u>	<u>25</u>
<u>Chalk</u>	<u>40</u>	<u>65</u>
<u>Sand</u>	<u>25</u>	<u>90</u>

Information upon completion of well:

(1) Diameter 4" inches.

(2) Total Depth 90 feet.

(3) Water Level 30 feet below top of ground.

(4) Cased to 90, Size 4"


(5) Screen: Size 4", Length 6'

(6) Were any formations sealed against pollution?
_____ yes, no.

If YES depth of formation _____

Why _____

Drillers Remarks: _____

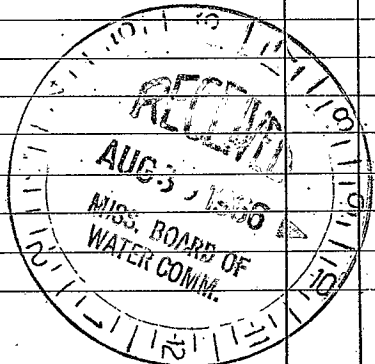

(Use Back Side)

Well No.

[The body of the document contains extremely faint and illegible text, likely bleed-through from the reverse side of the page. The text is too light to transcribe accurately.]