

CODED

Pike
A29
12-66

MISSISSIPPI
BOARD OF WATER COMMISSIONERS
416 North State Street
Jackson, Mississippi 39201

WATER WELL DRILLERS LOG

12-92 1966 Fitzgerald Water Well Serv Pike
date well completed firm name county well located

LANDOWNER: Gordon Willoughby
Johnston Station Miss

description of formations encountered	from	to
Topsoil	0	6
Gray Chalk	12	18
Coarse Sand & gravel	22	40

(mailing address)

WELL LOCATION:
sec 1 T 4 N 7 E
lives in town Johnston
(distance) (direction) (nearest town)


WELL PURPOSE: home
(home, irrigation, municipal, industrial)

WELL COMPLETION DATA:

- (1) diameter (inches) 4
- (2) total depth (feet) 40
- (3) static water level (feet) 15 below above top of ground.
- (4) casing plastic 32
(material) (depth)
4 if telescope see back.
(size)
- (5) screen 8' 32
(length) (depth to top)
4' plastic
(size) (material)
- (6) pump 1/4 5
(HP) (yield gpm)
Elec
(type power)
- (7) electric log no
(yes or no)


(organization running log)
- (8) how well bottom plugged Wood peg

DRILLERS REMARKS:

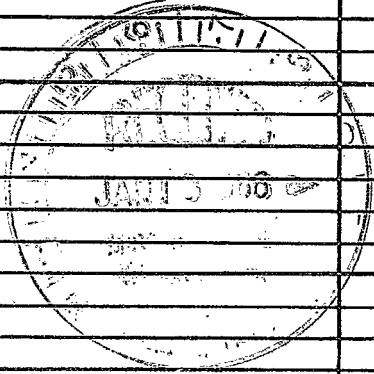

If well telescopes please sketch and show depths.

GROUND LEVEL

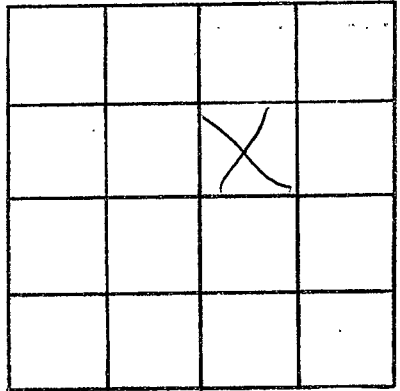

SECTION 1

Please indicate well location X.

ADDITIONAL INFORMATION

If more than one screen,
show locations of each on sketch.