

Pike CODED  
 A30  
 12-66

MISSISSIPPI  
 BOARD OF WATER COMMISSIONERS CODED  
 416 North State Street  
 Jackson, Mississippi 39201

WATER WELL DRILLERS LOG

12-71 1966 Fitzgerald W. Wallace Pike  
 date well completed firm name county well located

LANDOWNER: A.K. Buttrick  
RT 2 Summit, Miss


description of formations encountered	from	to
Top soil Red clay	0	12
Red Sand	28	40
Gravel	5	45
Red Sand	15	60
Coarse sand gravel	21	89

(mailing address)  
 WELL LOCATION:  
 sec. 30 T. 4 N. R. 7 E.  
5 miles W of Summit  
 (distance) (direction) (nearest town)

WELL PURPOSE: home  
 (home, irrigation, municipal, industrial)


- WELL COMPLETION DATA:
- (1) diameter (inches) 4 1/8
  - (2) total depth (feet) 81
  - (3) static water level (feet) 25 below above top of ground.
  - (4) casing plastic 7 3/8  
 (material) (depth)  
4 if telescope see back.  
 (size)
  - (5) screen 8' 7 3/8  
 (length) (depth to top)  
4' plastic  
 (size) (material)
  - (6) pump 1/2 sub 15  
 (HP) (yield gpm)  
Elec  
 (type power)
  - (7) electric log No  
 (yes or no)  
 (organization running log)
  - (8) how well bottom plugged Wood Peg

DRILLERS REMARKS:

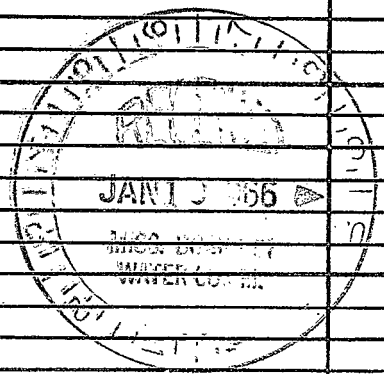

If well telescopes please sketch and show depths.

GROUND LEVEL

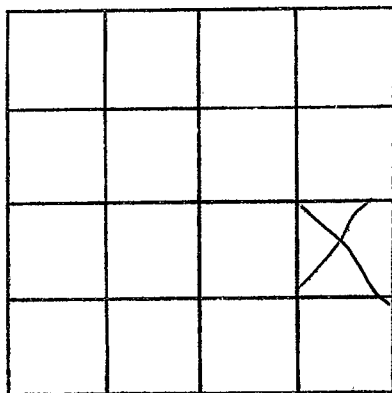

SECTION \_\_\_\_\_

Please indicate well location X.

ADDITIONAL INFORMATION

If more than one screen,  
show locations of each on sketch.