

Pike  
 A31 CODED  
 1-67

MISSISSIPPI  
 BOARD OF WATER COMMISSIONERS CODED  
 416 North State Street  
 Jackson, Mississippi 39201

WATER WELL DRILLERS LOG

JAN 70 1967 REEVES Well Pump Pike  
 date well completed firm name county well located

LANDOWNER: W. D. Sullivan  
 RFD-SUMMIT, F.  
 (mailing address)

description of formations encountered	from	to
Red Clay	0	12
Red Sand	12	65
Red Chalk	65	73
gravel Sand	73	92


WELL LOCATION:  
 sec. 4 T. 4 N R. 7 E  
 4 miles N of Summit.  
 (distance) (direction) (nearest town)

WELL PURPOSE: Home  
 (home, irrigation, municipal, industrial)

- WELL COMPLETION DATA:
- (1) diameter (inches) 4
  - (2) total depth (feet) 92
  - (3) static water level (feet) 70 below above top of ground.
  - (4) casing Plastic Bottom (material) (depth)
  - 4 (size) if telescope see back.
  - (5) screen 6' 26' (length) (depth to top)  
 4" Plastic (size) (material)
  - (6) pump 3/4 HP 10 (HP) (yield gpm)  
 Electric (type power)
  - (7) electric log No (yes or no)


(organization running log)  
 (8) how well bottom plugged wood

DRILLERS REMARKS:  
 set wellhead

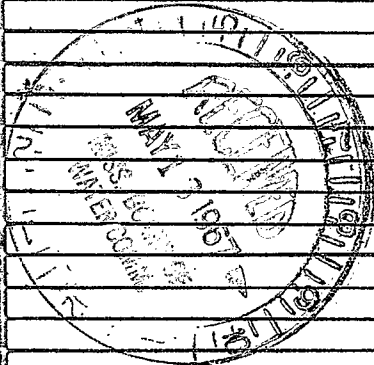

If well telescopes please sketch and show depths.

GROUND LEVEL

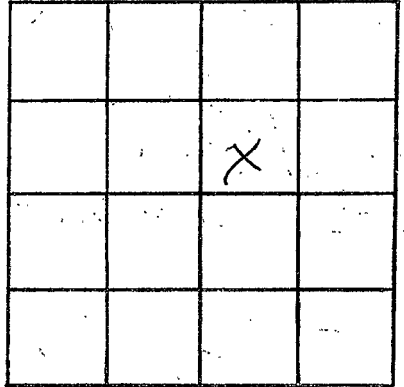

SECTION 4

Please indicate well location X.

ADDITIONAL INFORMATION

If more than one screen, show locations of each on sketch.