

Pike
 A32 CODED
 2-67

MISSISSIPPI
 BOARD OF WATER COMMISSIONERS
 416 North State Street
 Jackson, Mississippi 39201

CODED

WATER WELL DRILLERS LOG

Feb 13 1967 KEEVESWELL & Rump Pike
 date well completed firm name county well located

LANDOWNER: LAMAR
 Wallace
 Rt 5 Summit -
 (mailing address)

description of formations encountered	from	to
Red Clay	0	17
Red Sand	17	60
Sandy sand	60	85
Chalky sand	85	99

WELL LOCATION:
 sec. 4 T4 N R 7 E
 4 miles N of Summit
 (distance) (direction) (nearest town)

WELL PURPOSE: Home
 (home, irrigation, municipal, industrial)


WELL COMPLETION DATA:

- (1) diameter (inches) 4"
- (2) total depth (feet) 99
- (3) static water level (feet) 72 below top of ground
- (4) casing Plastic bottom (material) (depth)
- (5) screen 6' 93 (length) (depth to top)
 4" Plastic (size) (material)
- (6) pump 1/2 Sub 12 (HP) (yield gpm)
 Electric (type power)
- (7) electric log NO (yes or no)

(organization running log)

(8) how well bottom plugged Plug. Wood

DRILLERS REMARKS:
 New House.

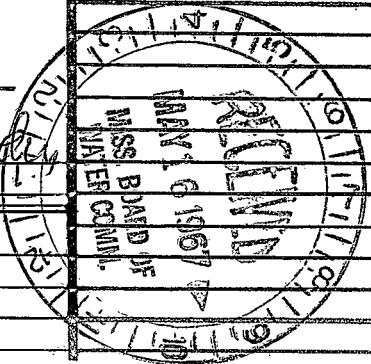


CODED

CODED

If well telescopes please sketch and show depths.

GROUND LEVEL

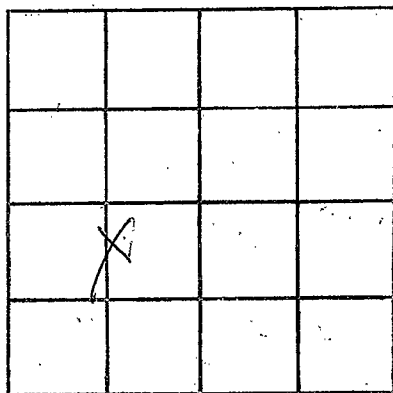

SECTION ck

Please indicate well location X.

ADDITIONAL INFORMATION

If more than one screen,
show locations of each on sketch.