

Pike
A33
3-67 CODED

MISSISSIPPI
BOARD OF WATER COMMISSIONERS
416 North State Street
Jackson, Mississippi 39201

CODED

WATER WELL DRILLERS LOG

Mar 1 1967 date well completed
Fitzgerald Well Service, Inc. firm name
Pike county well located

LANDOWNER: J. Archer Redd
Rural Route Summit (mailing address)

| description of formations encountered | from | to |
|---------------------------------------|------|----|
| Red clay | 0 | 15 |
| Red sand | 15 | 50 |
| Red sand & gravel | 50 | 75 |
| Coarse sand & gravel | 75 | 89 |


WELL LOCATION:
sec. 2 T 4 N R 7 E
5 miles N of Summit
(distance) (direction) (nearest town)

WELL PURPOSE: Home
(home, irrigation, municipal, industrial)

- WELL COMPLETION DATA:
- (1) diameter (inches) 4
 - (2) total depth (feet) 89
 - (3) static water level (feet) 70 below top of ground.
 - (4) casing Plastic, 81 (material), (depth), 4" (size) if telescope see back.
 - (5) screen 8' length, 81 (depth to top), 4" (size), Plastic (material)
 - (6) pump P (HP), 7 (yield gpm), Electric (type power)
 - (7) electric log No (yes or no)
 - (8) how well bottom plugged well plug

CODED


CODED

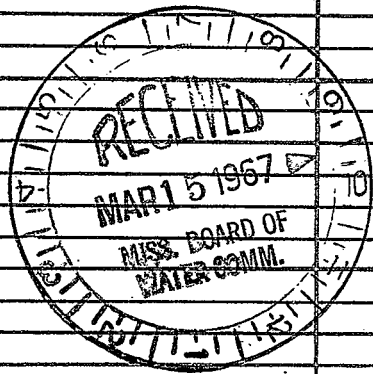

DRILLERS REMARKS:

If well telescopes please sketch and show depths.

GROUND LEVEL

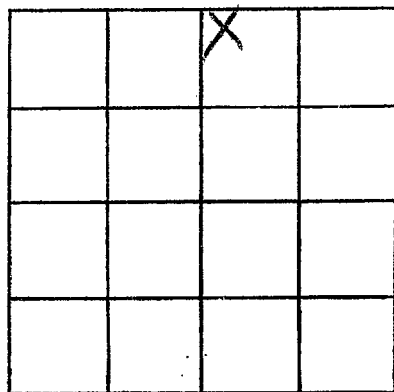

SECTION 2

Please indicate well location X.

ADDITIONAL INFORMATION

If more than one screen,
show locations of each on sketch.