

Pike
A34
4-67

MISSISSIPPI
BOARD OF WATER COMMISSIONERS
416 North State Street
Jackson, Mississippi 39201

CODED

WATER WELL DRILLERS LOG

4-6 1967 Edwards Water Service Pike
date well completed firm name county well located

LANDOWNER Douglas Sorrell

description of fomations encountered

from

to

Ret Summit

(mailing address)

Red gravel 0 16
Coar shells 16 35
Brown sand 35 70
Chalk 70 85
White sand 85 115
Gravel 115 125

WELL LOCATION:


sec 12 T 4 N 7 E
S W
3 miles NE of Summit
(distance) (direction) (nearest town)

WELL PURPOSE: Home
(home, irrigation, municipal, industrial)

WELL COMPLETION DATA:

- (1) diameter (inches) 4
- (2) total depth (feet) 125
- (3) static water level (feet) 25 below above top of ground.
- (4) casing plastic, 115
(material) (depth)
- 4 if telescope see back.
(size)
- (5) screen 81, 115
(length) (depth to top)
- 4, plastic
(size) (material)
- (6) pump 1/2 12
(HP) (yield gpm)
- 3hp
(type power)
- (7) electric log NO
(yes or no)
- (organization running log)
- (8) how well bottom plugged Weld plug


CODED

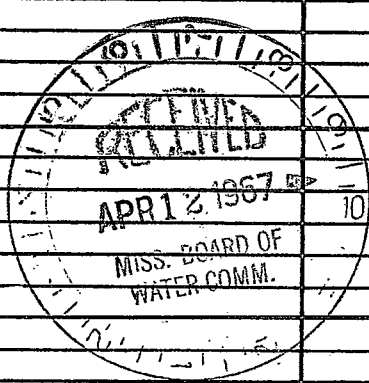

DRILLERS REMARKS:

If well telescopes please sketch and show depths.

GROUND LEVEL

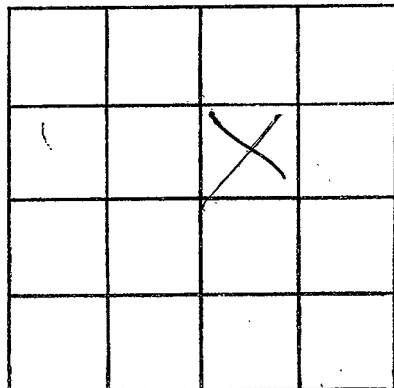

SECTION PH

Please indicate well location X.

ADDITIONAL INFORMATION

Lined area for additional information.

If more than one screen, show locations of each on sketch.