

Pice
 A 35
 4-67

MISSISSIPPI
 BOARD OF WATER COMMISSIONERS
 416 North State Street
 Jackson, Mississippi 39201

CODED

WATER WELL DRILLERS LOG

April 18 1967 Fitzgerald well drillers Pice
 date well completed firm name county well located

LANDOWNER:
4th District County, Brum
Summit, R. Beete
 (mailing address)

description of formations encountered	from	to
<u>Red clay</u>	<u>0</u>	<u>20</u>
<u>Red sand</u>	<u>20</u>	<u>30</u>
<u>Coarse sand & gravel</u>	<u>30</u>	<u>68</u>


WELL LOCATION:
 sec. 14 T. 4 N. R. 7 E.
1 1/2 miles N of Summit
 (distance) (direction) (nearest town)

WELL PURPOSE: Domestic
 (home, irrigation, municipal, industrial)

- WELL COMPLETION DATA:
- (1) diameter (inches) 4
 - (2) total depth (feet) 68
 - (3) static water level (feet) 30 below above top of ground.
 - (4) casing Plastic, 60,
 (material) (depth)
4" if telescope see back.
 (size)
 - (5) screen 8', 60'
 (length) (depth to top)
4", Plastic
 (size) (material)
 - (6) pump ? ?
 (HP) (yield gpm)
electric
 (type power)
 - (7) electric log no
 (yes or no)
 (organization running log)
 - (8) how well bottom plugged wool

CODED


CODED

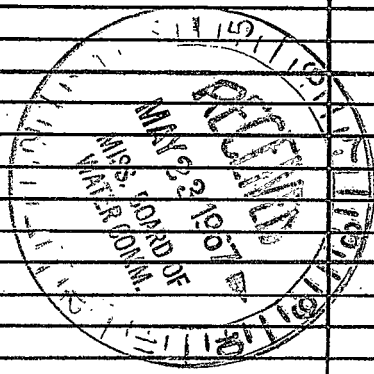

DRILLERS REMARKS:

If well telescopes please sketch and show depths.

GROUND LEVEL

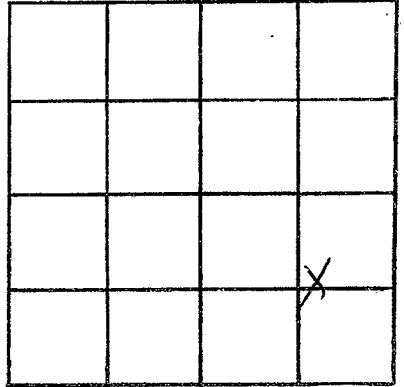

SECTION 14

Please indicate well location X.

ADDITIONAL INFORMATION

If more than one screen, show locations of each on sketch.