

PIKE
A36
5-67 CODED

MISSISSIPPI
BOARD OF WATER COMMISSIONERS
416 North State Street
Jackson, Mississippi 39201

CODED

WATER WELL DRILLERS LOG

May 20 1967 date well completed
67 Fitzgerald Water Well firm name
pike county well located

LANDOWNER: Buck Baker
Rt 4 Summit
(mailing address)

description of formations encountered	from	to
Red clay	0	25
Red sand	25	45
gravel sand	45	80

WELL LOCATION:
sec 35 T 4 N R 7 E S W
(distance) miles of (direction) of (nearest town)

WELL PURPOSE: home
(home, irrigation, municipal, industrial)

- WELL COMPLETION DATA:
- (1) diameter (inches) 4
 - (2) total depth (feet) 80
 - (3) static water level (feet) 60 below top of ground
 - (4) casing plastic 74 (material) (depth)
4 (size) if telescope see back.
 - (5) screen 6' 74 (length) (depth to top)
4 (size) plastic (material)
 - (6) pump Sub 1/2 14 (HP) (yield gpm)
Elec (type power)
 - (7) electric log No (yes or no)

(organization running log)
(8) how well bottom plugged Wood peg

DRILLERS REMARKS:




CODED

CODED

If well telescopes please sketch and show depths.

GROUND LEVEL

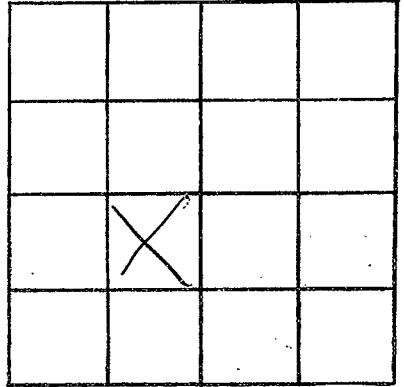

SECTION 35

Please indicate well location X.

ADDITIONAL INFORMATION

If more than one screen, show locations of each on sketch.