

Pike
A37
6-67

MISSISSIPPI
 BOARD OF WATER COMMISSIONERS
 416 North State Street
 Jackson, Mississippi 39201

CODED

WATER WELL DRILLERS LOG

June 30 19*67* *Reeseville* *Pike*
 date well completed firm name county well located

LANDOWNER: *J. G. Cobb*
RFD
Summit
 (mailing address)

description of formations encountered	from	to
<i>bed clay</i>	<i>0</i>	<i>18</i>
<i>Red Sand</i>	<i>18</i>	<i>60</i>
<i>Red Chalky Sand</i>	<i>60</i>	<i>70</i>
<i>Small pebbles and sand</i>	<i>70</i>	<i>96</i>

WELL LOCATION:
 sec. *10* T. *4* N. R. *7* E.
3 miles *W* of *Summit*
 (distance) (direction) (nearest town)

WELL PURPOSE: *Domestic*
 (home, irrigation, municipal, industrial)


WELL COMPLETION DATA:

- (1) diameter (inches) *4 1/2"*
- (2) total depth (feet) *96'*
- (3) static water level (feet) *67'* below above top of ground.
- (4) casing *Plastic Bottom*
 (material) (depth)
- (size) if telescope see back.
- (5) screen *6'* *90'*
 (length) (depth to top)
- 4"* *Plastic*
 (size) (material)
- (6) pump *6.5 hp* *12"*
 (HP) (yield gpm)
- Electric*
 (type power)
- (7) electric log *NO*
 (yes or no)
- (organization running log)
- (8) how well bottom plugged *wooden plug*

DRILLERS REMARKS: *old well Bad*


CODED

CODED

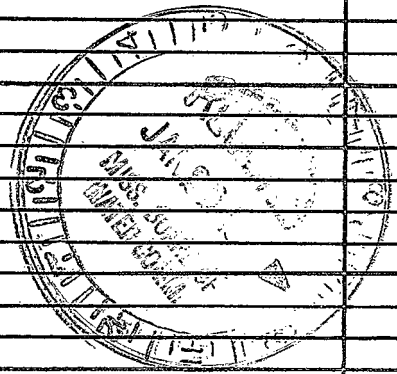

If well telescopes please sketch and show depths.

GROUND LEVEL

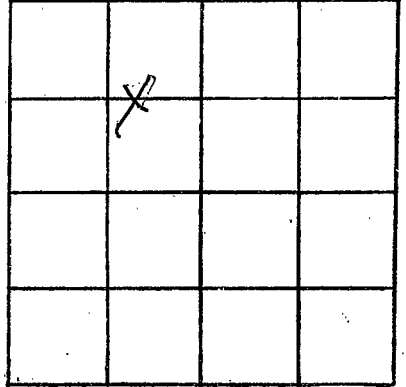

SECTION 10

Please indicate well location X.

ADDITIONAL INFORMATION

Multiple horizontal lines for additional information.

If more than one screen, show locations of each on sketch.