

Pike  
A38  
8-67

MISSISSIPPI  
BOARD OF WATER COMMISSIONERS  
416 North State Street  
Jackson, Mississippi 39201

CODED

WATER WELL DRILLERS LOG

Aug 31 1967 Fitgerald Well Service Pike  
date well completed firm name county well located

LANDOWNER: Pine Grove Church  
R Route Summit, Miss.  
(mailing address)

description of formations encountered	from	to
<u>Red clay</u>	<u>0</u>	<u>20</u>
<u>Red sand</u>	<u>20</u>	<u>108</u>
<u>Orange sand &amp; gravel</u>	<u>108</u>	<u>114</u>

WELL LOCATION:  
sec. 21 T. 9 N R. 7 E  
5 miles W of Summit  
(distance) (direction) (nearest town)

WELL PURPOSE: stone  
(home, irrigation, municipal, industrial)

WELL COMPLETION DATA:


- (1) diameter (inches) 4"
- (2) total depth (feet) 114'
- (3) static water level (feet) 70 below top of ground.
- (4) casing Plaster, 108'  
(material) (depth)  
4"  
(size) If telescope see back.
- (5) screen 6', 108'  
(length) (depth to top)  
4", Plaster  
(size) (material)
- (6) pump 7 7  
(HP) (yield gpm)  
Electric  
(type power)
- (7) electric log No  
(yes or no)  
(organization running log)
- (8) how well bottom plugged about 1/2

DRILLERS REMARKS:



If well telescopes please sketch and show depths.

GROUND LEVEL

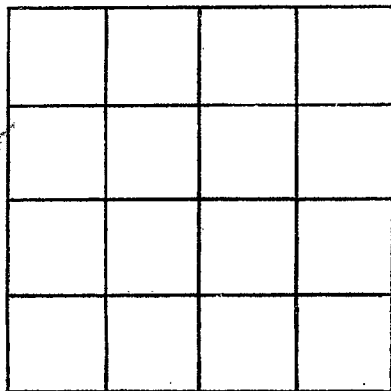

SECTION 21

Please indicate well location X.

ADDITIONAL INFORMATION

If more than one screen, show locations of each on sketch.