

CODED

MISSISSIPPI
BOARD OF WATER COMMISSIONERS
416 North State Street
Jackson, Mississippi 39201

WATER WELL DRILLERS LOG

File
741
8-67

Aug 23 1967 Fitzgerald Well Service Peru
date well completed firm name county well located

LANDOWNER: James Bures

description of formations encountered from to

R Route Summit, Miss.
(mailing address)

Red clay 0 25
red sand 25 60
Coarse sand & gravel 60 75

WELL LOCATION:
sec. 23 T 7 N R. 3 E
S W
1 miles NW of Summit
(distance) (direction) (nearest town)

WELL PURPOSE: Home
(home, irrigation, municipal, industrial)

WELL COMPLETION DATA:

- (1) diameter (inches) 4"
- (2) total depth (feet) 75'
- (3) static water level (feet) 50 below above top of ground.
- (4) casing Plastic, 69',
(material) (depth)
4"
(size) if telescope see back.
- (5) screen 6', 69'
(length) (depth to top)
4", Plastic
(size) (material)
- (6) pump ? ?
(HP) (yield gpm)
Electric
(type power)
- (7) electric log No.
(yes or no)
(organization running log)
- (8) how well bottom plugged wood peg

CODED


CODED



DRILLERS REMARKS:

If well telescopes please sketch and show depths.

GROUND LEVEL

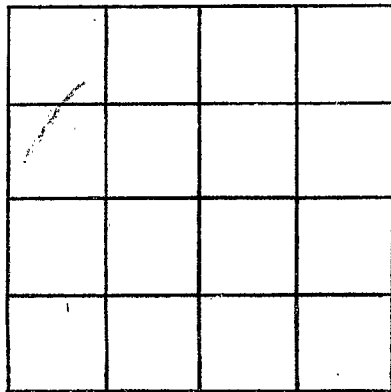

SECTION 23

Please indicate well location X.

ADDITIONAL INFORMATION

If more than one screen,
show locations of each on sketch.