

Oeko
 A43
 9-67

CODED

MISSISSIPPI
 BOARD OF WATER COMMISSIONERS CODED
 416 North State Street
 Jackson, Mississippi 39201

WATER WELL DRILLERS LOG

Sept 19 19 *67* *Fitzgerald Well Drilling* *Oeko*
 date well completed firm name county well located

LANDOWNER: *Curtis Clemon*
 RR. *Summit Miss.*
 (mailing address)

description of formations encountered	from	to
<i>Red clay</i>	<i>0</i>	<i>20</i>
<i>red sand</i>	<i>20</i>	<i>60</i>
<i>Coarse sand & gravel</i>	<i>60</i>	<i>70</i>
<i>Red silver sand</i>	<i>70</i>	<i>80</i>
<i>Coarse sand & gravel</i>	<i>80</i>	<i>99</i>

WELL LOCATION:
 sec. *6* T *4* N R *7* E
S *W*
8 miles *NW* of *Summit*
 (distance) (direction) (nearest town)

WELL PURPOSE:
 (home, irrigation, municipal, industrial)


WELL COMPLETION DATA:

- (1) diameter (inches) *4*
- (2) total depth (feet) *99*
- (3) static water level (feet) *60* below above top of ground.
- (4) casing *Plastic*, *93*,
 (material) (depth)
4"
 (size) if telescope see back.
- (5) screen *6'*, *93'*
 (length) (depth to top)
4", *Plastic*
 (size) (material)
- (6) pump *1* *9*
 (HP) (yield gpm)
Elco
 (type power)
- (7) electric log *No*
 (yes or no)
Fitzgerald Well Drilling
 (organization running log)
- (8) how well bottom plugged *wood plug*

CODED

CODED

DRILLERS REMARKS:

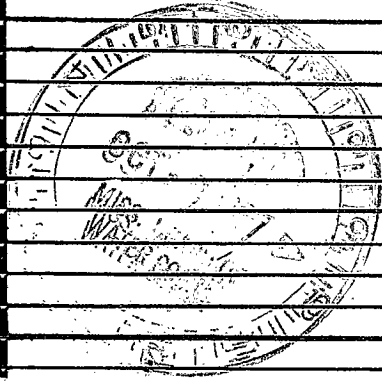

If well telescopes please sketch and show depths.

GROUND LEVEL

7			

SECTION 6

Please indicate well location X.

ADDITIONAL INFORMATION

If more than one screen,
show locations of each on sketch.