

Pike
A44
1-68

MISSISSIPPI
BOARD OF WATER COMMISSIONERS
416 North State Street
Jackson, Mississippi 39201

WATER WELL DRILLERS LOG

Jan 20 1968 date well completed
Fitzgerald Well Service firm name
Pike county well located

LANDOWNER: Charles Faulk
RR Summit, Miss
(mailing address)

description of formations encountered	from	to
red clay	0	15
red sand	15	75
coarse bank gravel	75	80
red sand	80	85
coarse sand & gravel	85	96

WELL LOCATION:
sec. 24 T 4 N R 7 E
S W
1 miles N of Summit
(distance) (direction) (nearest town)

WELL PURPOSE: Home
(home, irrigation, municipal, industrial)

- WELL COMPLETION DATA:
- (1) diameter (inches) 4
 - (2) total depth (feet) 95
 - (3) static water level (feet) 75 below top of ground.
 - (4) casing Plastic, 89' (material) (depth)
49" (size) if telescope see back.
 - (5) screen 6' length, 89' depth to top
4" (size) Plastic (material)
 - (6) pump 1/2 HP, 12 (yield gpm)
electric (type power)
 - (7) electric log NO (yes or no)
(organization running log)
 - (8) how well bottom plugged wood peg

CODED


CODED

RECEIVED
JAN 31 1968
MISSISSIPPI BOARD OF WATER COMMISSIONERS

DRILLERS REMARKS:

If well telescopes please sketch and show depths.

GROUND LEVEL

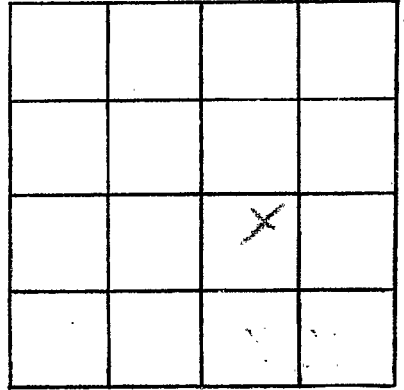

SECTION 27

Please indicate well location X.

ADDITIONAL INFORMATION

If more than one screen,
show locations of each on sketch.