

MISSISSIPPI
 BOARD OF WATER COMMISSIONERS
 416 North State Street
 Jackson, Mississippi 39201

CODED

WATER WELL DRILLERS LOG

Pike
 A 45
 1-68

CODED

Jan 29 1968 date well completed
 Reeswell Drillers firm name
 Pike county well located

LANDOWNER: Mary Strath
 Rt. 4, Box 43
 Summit Miss
 (mailing address)

description of formations encountered	from	to
Red clay	0	12
Small gravel & sand	12	35
Sand Rock	35	36
Sand and gravel with small Sand Rocks	36	55
Peagravel	55	64

WELL LOCATION:
 sec. 2 T 4 N R 7 E
 4 miles N of Summit
 (distance) (direction) (nearest town)

WELL PURPOSE: Home
 (home, irrigation, municipal, industrial)

WELL COMPLETION DATA:

- (1) diameter (inches) 4"
- (2) total depth (feet) 64
- (3) static water level (feet) 35 below top of ground.
- (4) casing Plastic Bottom (material) (depth)
- (5) screen 6' 58" (length) (depth to top)
 Plastic (material)
- (6) pump Electric (type power)
- (7) electric log NO (yes or no)


CODED

CODED

(organization running log)


(8) how well bottom plugged
 wooden plug

DRILLERS REMARKS:

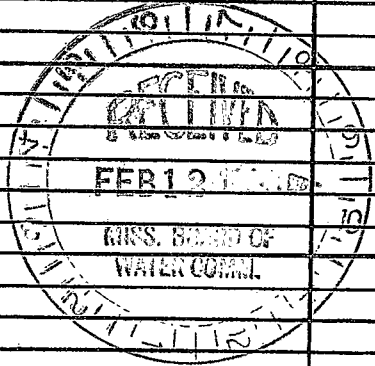

If well telescopes please sketch and show depths.

GROUND LEVEL

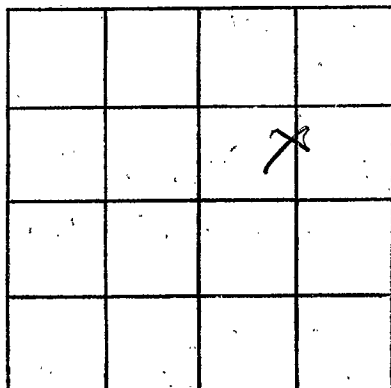

SECTION 2

Please indicate well location X.

ADDITIONAL INFORMATION

If more than one screen, show locations of each on sketch.