

PRICE  
A 47  
3-2-66

MISSISSIPPI BOARD OF WATER COMMISSIONERS

CODED WATER WELL DRILLERS LOG CODED

Date: 3-2, 1966, Driller: Chester Reeves County Pike  
(When well drilled) (Name) (Where well is located)

(1) Owner of Land: Kelly Mack  
(Name)  
P.O. Summit  
(Address)  
(2) Location: 1/4, 1/4, Sec. 9 T 7 R 7  
4 miles N.W. of Summit  
(distance) (direction) (Nearest Town)  
(3) Topography: Kelly  
(Hilly) (Flat) (Level)  
(4) Purpose of Well: Domestic  
(Domestic Irrigation  
Municipal, Industrial, Other)

Description & Color of Materials Sand, Clay, Red Clay, Shell, etc.	Thick- ness Feet	Depth Feet
Clay Red sandstone gravel	18	18
Gravel brown sand	42	60
Sand	22	82

CODED

CODED


Information upon completion of well:

(1) Diameter 4 inches.  
(2) Total Depth 82 feet.  
(3) Water Level 55 feet below top of ground.  
(4) Cased to Bottom, Size 4"  
(5) Screen: Size 4", Length 6'  
(6) Were any formations sealed against pollution?  
yes, no.

If YES depth of formation

Why

Drillers Remarks: New house  
Yield in gpm: 15  
Size pump: 1/2 H.P. Sub -  
Type power: Electric -

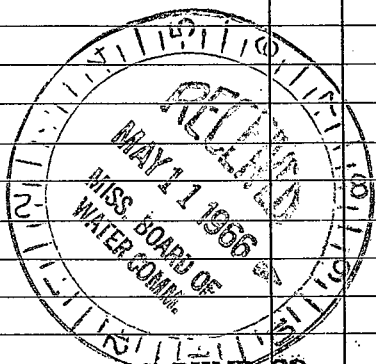

REEVES WELL & PUMP CO.  
P. O. BOX 71 - PHONE 684-1451  
McCOMB, MISS.

