

PIKE  
A 48  
4-CODED

MISSISSIPPI  
BOARD OF WATER COMMISSIONERS  
416 North State Street  
Jackson, Mississippi 39201

CODED

WATER WELL DRILLERS LOG

April 19 1968 J.T. Covington Pike  
date well completed firm name county well located

LANDOWNER: Milton Boyd

description of formations encountered

from to

(mailing address)

WELL LOCATION:

sec. 11 T 4 N R 7 E  
S W  
3 miles North of Summit  
(distance) (direction) (nearest town)

WELL PURPOSE: Home  
(home, irrigation, municipal, industrial)

WELL COMPLETION DATA:


- (1) diameter (inches) 4"
- (2) total depth (feet) 108'
- (3) static water level (feet) 40' below above top of ground.
- (4) casing Plastic, 108' (material) (depth)
- (size) If telescope see back.
- (5) screen 6' 102' (length) (depth to top)
- 4" Plastic (size) (material)
- (6) pump 1/2 9 (HP) (yield gpm)
- A.C. (type power)
- (7) electric log (yes or no)
- (organization running log)
- (8) how well bottom plugged wood

DRILLERS REMARKS:

very sand 0 43  
~~43 108~~  
cherty sand 43 90  
90 108

CODED

CODED

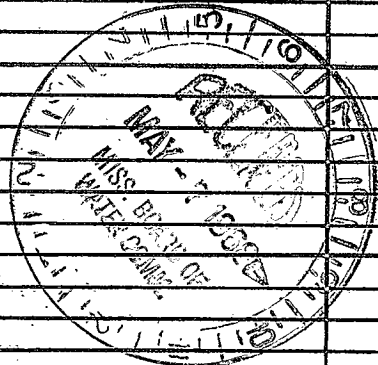

If well telescopes please sketch and show depths.

GROUND LEVEL

		●	

SECTION \_\_\_\_\_

Please indicate well location X.

ADDITIONAL INFORMATION

If more than one screen, show locations of each on sketch.