

MISSISSIPPI  
BOARD OF WATER COMMISSIONERS  
416 North State Street  
Jackson, Mississippi 39201

CODED

WATER WELL DRILLERS LOG

File  
A49  
5-68 CODED

May 13 1968 of Reverend Pump - Pike  
date well completed firm name county well located

LANDOWNER: Ruby Carpenter  
RR #7 - Summit  
(mailing address)

description of formations encountered	from	to
clay	0	10
red sand	0	60
blue gravel sand	60	78

WELL LOCATION:  
sec. 36 T. 4 N. R. 17 E  
1 miles N of McLain  
(distance) (direction) (nearest town)

WELL PURPOSE: farm  
(home, irrigation, municipal, industrial)

- WELL COMPLETION DATA:
- (1) diameter (inches) 4"
  - (2) total depth (feet) 78
  - (3) static water level (feet) 40 below top of ground
  - (4) casing Plastic Ballam  
(material) (depth)
  - (size) if telescope see back.
  - (5) screen 6' 72'  
(length) (depth to top)
  - 4" Plastic  
(size) (material)
  - (6) pump Edithing  
(HP) (yield gpm)
  - electric  
(type power)
  - (7) electric log no  
(yes or no)
  - (organization running log)
  - (8) how well bottom plugged no

DRILLERS REMARKS:  
red well


CODED

CODED

JUL 10 1968  
MISS. BOARD OF  
WATER COMMISSIONERS

If well telescopes please sketch and show depths.

GROUND LEVEL

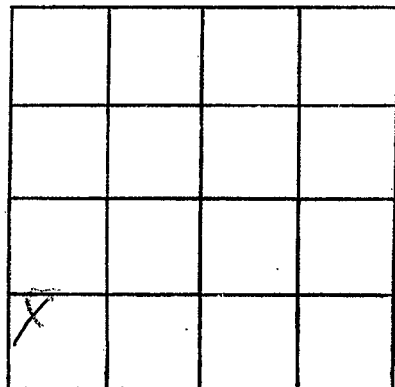

SECTION 36

Please indicate well location X.

ADDITIONAL INFORMATION

If more than one screen, show locations of each on sketch.