

PIKE
 A 50 CODED
 4-68

MISSISSIPPI
 BOARD OF WATER COMMISSIONERS
 416 North State Street
 Jackson, Mississippi 39201

CODED

WATER WELL DRILLERS LOG

date well completed April 2 1968 firm name SB Berns and Kump county well located Pike

LANDOWNER: Geraltine
White
RFD Summit
 (mailing address)

description of formations encountered	from	to
Sandy clay	0	12
Red Chalk	12	31
Red Sand	31	55
Red Sand Sand		
Wipe with good	55	70
Small gravel and Coarsesant	70	84

WELL LOCATION:
 sec 34 T 4 N R 7 E
1 miles SW Summit
 (distance) (direction) (nearest town)

WELL PURPOSE: Home
 (home, irrigation, municipal, industrial)

WELL COMPLETION DATA:
 (1) diameter (inches) 4"
 (2) total depth (feet) 84
 (3) static water level (feet) 50 below top of ground
 (4) casing Plastic pattern
 (material) (depth)

(size) If telescope see back.
 (5) screen 6' 78'
 (length) (depth to top)
4" Plastics
 (size) (material)
 (6) pump bold 8
 (HP) (yield gpm)
Elect
 (type power)

(7) electric log NO
 (yes or no)

(organization running log)

(8) how well bottom plugged
wooden plug

DRILLERS REMARKS:

CODED


CODED

MAY 27 1968

MISS. BOARD OF
 WATER COMMISSIONERS

If well telescopes please sketch and show depths.

GROUND LEVEL

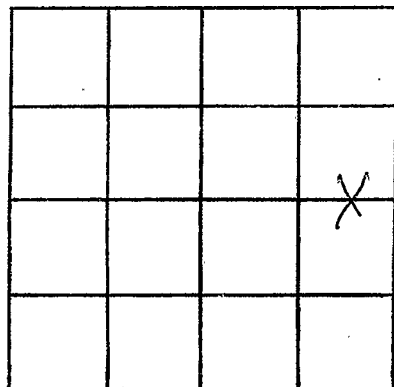

SECTION 34

Please indicate well location X.

ADDITIONAL INFORMATION

If more than one screen, show locations of each on sketch.