

PIKE  
A51  
4-68

CODED

MISSISSIPPI  
BOARD OF WATER COMMISSIONERS  
416 North State Street  
Jackson, Mississippi 39201

CODED

WATER WELL DRILLERS LOG

April 9, 1968 *Peoples Well Drilling Co - Pike*  
 date well completed firm name county well located

LANDOWNER *James Caruth*  
*PO Box 100*  
*Summit*  
 (mailing address)

WELL LOCATION:  
 sec. 35 T. 4 N. R. 7 E  
4 miles N of Summit  
 (distance) (direction) (nearest town)

WELL PURPOSE: *Drain*  
 (home, irrigation, municipal, industrial)

WELL COMPLETION DATA:

- (1) diameter (inches) 4"
- (2) total depth (feet) 115
- (3) static water level (feet) 75 below top of ground
- (4) casing plastic bottom  
 (material) (depth)
- (5) screen 6' 109  
 (length) (depth to top)
- (6) pump 1/2 HP 12  
 (type power) (yield gpm)
- (7) electric log NO  
 (yes or no)

(organization running log)

(8) how well bottom plugged are clogging

DRILLERS REMARKS: all well bad

description of formations encountered	from	to
<i>Red sand clay</i>	<i>0</i>	<i>12</i>
<i>Red sand &amp; gravel</i>	<i>12</i>	<i>30</i>
<i>pink chalky sand</i>	<i>30</i>	<i>60</i>
<i>brown gravel</i>	<i>60</i>	<i>68</i>
<i>pink chalk</i>	<i>68</i>	<i>85</i>
<i>Coarse sand &amp; gravel</i>	<i>85</i>	<i>92</i>
<i>gravel &amp; chalk</i>	<i>92</i>	<i>100</i>
<i>clear coarse sand &amp; gravel</i>	<i>100</i>	<i>115</i>


CODED

MAY 27 1968

MISS. BOARD OF WATER COMMISSIONERS

If well telescopes please sketch and show depths.

GROUND LEVEL

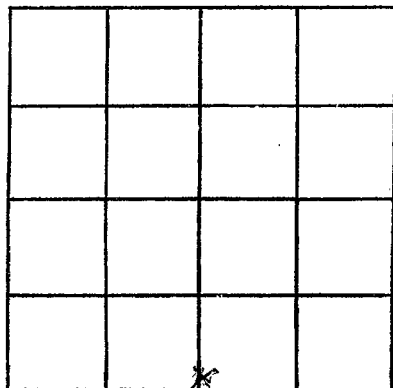

SECTION 35

Please indicate well location X.

ADDITIONAL INFORMATION

If more than one screen, show locations of each on sketch.