

**MISSISSIPPI  
BOARD OF WATER COMMISSIONERS**  
416 North State Street  
Jackson, Mississippi 39201

CODED

**WATER WELL DRILLERS LOG**

**PIKE CODED**  
A 52  
6-68

3 Jul 1968 J. T. Carver & Son Pike  
date well completed firm name county well located

LANDOWNER: Robert Kelly

description of formations encountered	from	to
Clay	0	35
Chalk	36	45
Sand	46	90
Sand shale	91	106

Summit, Miss.  
(mailing address)

WELL LOCATION:  
sec. 3 T. 4 N. R. 7 E.  
7 miles N of Summit  
(distance) (direction) (nearest town)

WELL PURPOSE:  
(home, irrigation, municipal, industrial)

- WELL COMPLETION DATA:
- (1) diameter (inches) 4"
  - (2) total depth (feet) 106
  - (3) static water level (feet) 70 ~~below~~ above top of ground.
  - (4) casing Plastic 106  
(material) (depth)  
4" if telescope see back.  
(size)
  - (5) screen 6' 100  
(length) (depth to top)  
4" P.  
(size) (material)
  - (6) pump 1/2 8  
(HP) (yield gpm)  
Elec  
(type power)
  - (7) electric log \_\_\_\_\_  
(yes or no)  
\_\_\_\_\_  
(organization running log)
  - (8) how well bottom plugged \_\_\_\_\_

CODED


CODED

MISSISSIPPI  
BOARD OF  
WATER COMMISSIONERS

DRILLERS REMARKS: \_\_\_\_\_

If well telescopes please sketch and show depths.

GROUND LEVEL

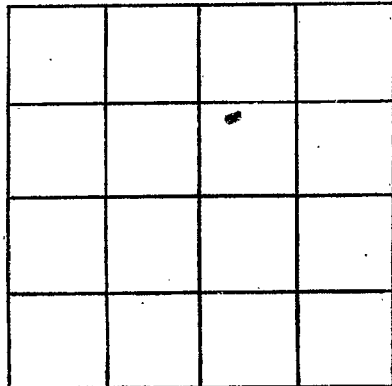

SECTION 3

Please indicate well location X.

ADDITIONAL INFORMATION

If more than one screen,  
show locations of each on sketch.