

Pike  
 A5 **CODED**  
 6-68

MISSISSIPPI  
 BOARD OF WATER COMMISSIONERS  
 416 North State Street  
 Jackson, Mississippi 39201

**CODED**

WATER WELL DRILLERS LOG

June 10 1968 *Reenswell Pump* *Pike*  
 date well completed firm name county well located

LANDOWNER: *H. M. ...*  
*R. F. ...*

description of formations encountered	from	to
<i>bed clay</i>	<i>0</i>	<i>18</i>
<i>bed sand</i>	<i>18</i>	<i>60</i>
<i>sand, gravel, clay</i>	<i>60</i>	<i>91</i>
<i>gravel (sand)</i>	<i>90</i>	<i>112</i>

(mailing address)

WELL LOCATION:

sec. *4* T. *4* N. R. *7* E.  
*4* miles *NW* of *Summit*  
 (distance) (direction) (nearest town)

WELL PURPOSE: *Home*  
 (home, irrigation, municipal, industrial)

WELL COMPLETION DATA:

- (1) diameter (inches) *4'*
- (2) total depth (feet) *112*
- (3) static water level (feet) *73* below top of ground.
- (4) casing *Plastic Ballast*  
 (material) (depth)
- (size) If telescope see back.
- (5) screen *6'* *106*  
 (length) (depth to top)  
*4"* *Plastic*  
 (size) (material)
- (6) pump *1/2 HP* *12*  
 (HP) (yield gpm)  
*Electric*  
 (type power)
- (7) electric log *NO*  
 (yes or no)

**CODED**

**CODED**

(organization running log)


(8) how well bottom plugged  
*wooden plug*

DRILLERS REMARKS:  
*red well hole*

JUL 18 1968  
 MISS. BOARD OF  
 WATER COMMISSIONERS

If well telescopes please  
sketch and show depths.

GROUND LEVEL

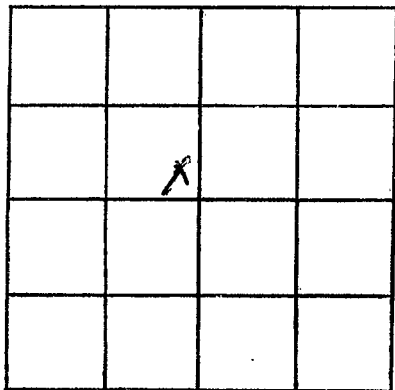

SECTION 4

Please indicate well location X.

ADDITIONAL INFORMATION

If more than one screen,  
show locations of each on sketch.