

Pike
A54 CODED
5-68

MISSISSIPPI
BOARD OF WATER COMMISSIONERS
416 North State Street
Jackson, Mississippi 39201

CODED

WATER WELL DRILLERS LOG

5-31 1968 Fitzgerald well serv Pike
date well completed firm name county well located

LANDOWNER: Zeppie Stovous
RR Smithdale Miss
(mailing address)

description of formations encountered	from	to
<u>Red clay</u>	<u>0</u>	<u>20</u>
<u>Red sand</u>	<u>20</u>	<u>60</u>
<u>Heavy gravel</u>	<u>60</u>	<u>102</u>


WELL LOCATION:
sec. 31 T. 4 N. R. 7 E.
5 miles SW of Summit
(distance) (direction) (nearest town)

WELL PURPOSE: Home
(home, irrigation, municipal, industrial)

CODED

- WELL COMPLETION DATA:
- (1) diameter (inches) 4
 - (2) total depth (feet) 102
 - (3) static water level (feet) 75 below top of ground.
 - (4) casing Plastic, 96'
(material) (depth)
4" if telescope see back.
(size)
 - (5) screen 6', 96'
(length) (depth to top)
4", Plastic
(size) (material)
 - (6) pump 3 3
(HP) (yield gpm)
 - elec
(type power)
 - (7) electric log no
(yes of no)
(organization running log)
 - (8) how well bottom plugged wool fiber


CODED

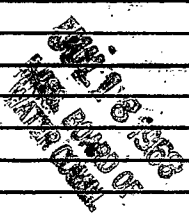

DRILLERS REMARKS:

If well telescopes please sketch and show depths.

GROUND LEVEL

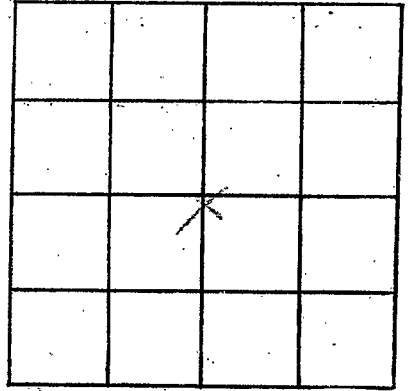

SECTION 31

Please indicate well location X.

ADDITIONAL INFORMATION

If more than one screen,
show locations of each on sketch.