

*Pike*  
*A 55*  
*6-68*

MISSISSIPPI  
 BOARD OF WATER COMMISSIONERS CODED  
 416 North State Street  
 Jackson, Mississippi 39201

WATER WELL DRILLERS LOG

*June 13* 1968 *S. T. Carington* *Pi. Itz*  
 date well completed firm name county well located

LANDOWNER: *M. L. Wooten*  
*Summit Miss*  
 (mailing address)

description of formations encountered	from	to
<i>clay</i>	<i>0</i>	<i>30</i>
<i>clay sand</i>	<i>30</i>	<i>60</i>
<i>sand &amp; gravel</i>	<i>60</i>	<i>108</i>

WELL LOCATION:  
 sec *33* T *4* N R *7* E  
           *3* W S            *5* W  
 (distance) miles (direction) of (nearest town)

WELL PURPOSE: *Home*  
 (home, irrigation, municipal, industrial)

WELL COMPLETION DATA:

(1) diameter (inches) *4"*

(2) total depth (feet) *108'*

(3) static water level (feet) *83'* below top of ground.

(4) casing *Plastic*, *102'*  
 (material) (depth)  
*4"* if telescope see back.  
 (size)

(5) screen *6'*, *108'*  
 (length) (depth to top)  
*4"*, *Plastic*  
 (size) (material)

(6) pump *1/2*, *9*  
 (HP) (yield gpm)  
*P.C.*  
 (type power)

(7) electric log \_\_\_\_\_  
 (yes or no)  
 \_\_\_\_\_  
 (organization running log)

(8) how well bottom plugged *wood*

CODED


AUG 8 1968

MISS. Bd. OF  
 WATER COMM.

DRILLERS REMARKS:

If well telescopes please sketch and show depths.

GROUND LEVEL

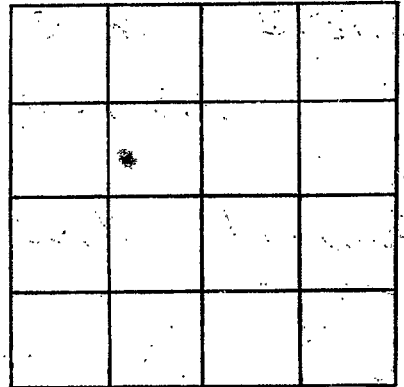

SECTION 33

Please indicate well location X.

ADDITIONAL INFORMATION

If more than one screen,  
show locations of each on sketch.