

MISSISSIPPI  
 BOARD OF WATER COMMISSIONERS  
 416 North State Street  
 Jackson, Mississippi 39201

CODED

WATER WELL DRILLERS LOG

Pike  
 A 56  
 7-68

July 16 1968 J.T. Cowington Pike  
 date/well completed firm name county well located

LANDOWNER: Willie Watkins

description of formations encountered

from

to

Summit, Miss  
 (mailing address)

2 1/2' clay  
 sand  
 2 1/2' clay  
 sand

0 35  
 35 80  
 80 105  
 105 150

WELL LOCATION:


sec 1 T 4 N R 2 E  
 8 NW S NE W  
 miles west of Summit  
 (distance) (direction) (nearest town)

WELL PURPOSE: Home  
 (home, irrigation, municipal, industrial)

CODED

WELL COMPLETION DATA:


- (1) diameter (inches) 4"
- (2) total depth (feet) 150'
- (3) static water level (feet) 80' below top of ground
- (4) casing Plastic 1 1/2" (material) (depth)  
 4" (size) if telescope see back.
- (5) screen 6' 150' (length) (depth to top)  
 4" Plastic (size) (material)
- (6) pump 2 (HP) 8 (yield gpm)  
 P.c. (type power)
- (7) electric log (yes or no)  
 (organization running log)
- (8) how well bottom plugged wood

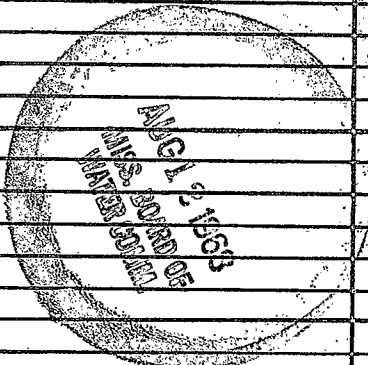

DRILLERS REMARKS:

If well telescopes please sketch and show depths.

GROUND LEVEL

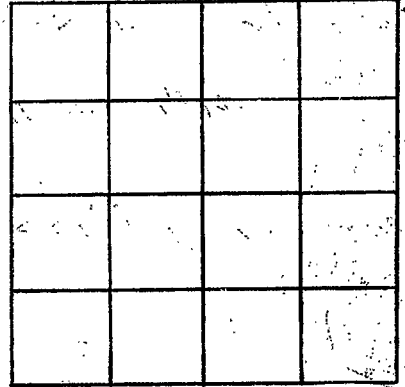

SECTION 1

Please indicate well location X.

ADDITIONAL INFORMATION

If more than one screen, show locations of each on sketch.