

Pike
A 57
768

MISSISSIPPI
BOARD OF WATER COMMISSIONERS
416 North State Street
Jackson, Mississippi 39201


CODED

WATER WELL DRILLERS LOG

July 2 1968 J.T. Conroy Pike
date well completed firm name county well located


LANDOWNER	description of formations encountered	from	to
Jimmy Johnston			
Summit, Miss (mailing address)	2 1/2' clay Sand clay sand	0 45 70 90	45 70 90 130
WELL LOCATION:			
sec. <u>8</u> T. <u>4</u> N. R. <u>7</u> E. <u>6</u> miles North of <u>Summit</u> (distance) (direction) (nearest town)			
WELL PURPOSE: <u>Home</u> (home, irrigation, municipal, industrial)			
WELL COMPLETION DATA:			
(1) diameter (inches) <u>4"</u>			
(2) total depth (feet) <u>130'</u>			
(3) static water level (feet) <u>85'</u> below above top of ground.			
(4) casing <u>Plastic, 126'</u> (material) (depth)			
<u>9"</u> if telescope see back. (size)			
(5) screen <u>6'</u> , <u>130'</u> (length) (depth to top)			
<u>4"</u> , <u>Plastic</u> (size) (material)			
(6) pump <u>1/2</u> , <u>9</u> (HP) (yield gpm)			
<u>P.C.</u> (type power)			
(7) electric log _____ (yes or no)			
_____ (organization running log)			
(8) how well bottom plugged <u>wood</u>			
DRILLERS REMARKS:			

CODED

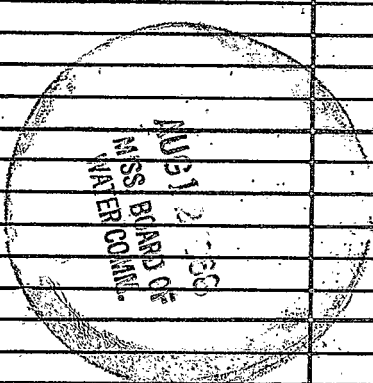

If well telescopes please sketch and show depths.

GROUND LEVEL

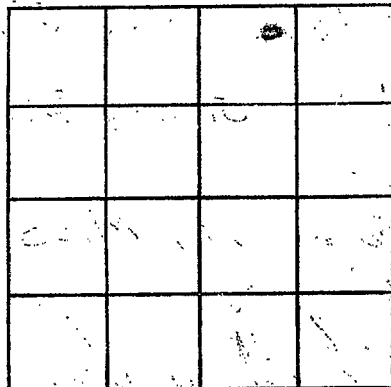

SECTION 8

Please indicate well location X.

ADDITIONAL INFORMATION

If more than one screen, show locations of each on sketch.