

MISSISSIPPI
BOARD OF WATER COMMISSIONERS
416 North State Street
Jackson, Mississippi 39201

CODED

WATER WELL DRILLERS LOG

PIKE
A 58
8-68

city 6 1968 Fitzgerald well Pike
 date well completed firm name county well located

LANDOWNER: Glenn Alexander description of formations encountered from to

R.R. Summit, Miss.
 (mailing address)

WELL LOCATION:

sec. 9 T. 4 N. R. 7 E.
2 miles NW of Summit
 (distance) (direction) (nearest town)


WELL PURPOSE: Home
 (home, irrigation, municipal, industrial)

WELL COMPLETION DATA:

- (1) diameter (inches) 8"
- (2) total depth (feet) 80'
- (3) static water level (feet) 50' below above top of ground.
- (4) casing Plastic 74'
 (material) (depth)
4" if telescope see back.
 (size)
- (5) screen 6' 74'
 (length) (depth to top)
4" Plastic
 (size) (material)
- (6) pump 1/2 12
 (HP) (yield gpm)
Electric
 (type power)
- (7) electric log Yes
 (yes or no)
 (organization running log)
- (8) how well bottom plugged wood peg

Description of formations encountered	from	to
<u>Red clay</u>	<u>0</u>	<u>15</u>
<u>Red chalk</u>	<u>15</u>	<u>40</u>
<u>Red sand</u>	<u>40</u>	<u>60</u>
<u>Coarse sand</u>	<u>60</u>	<u>70</u>
<u>Coarse sand & gravel</u>	<u>70</u>	<u>80</u>


CODED

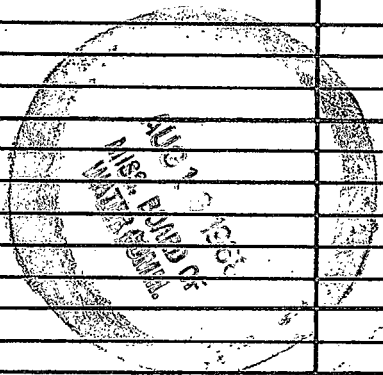

DRILLERS REMARKS:

If well telescopes please sketch and show depths.

GROUND LEVEL

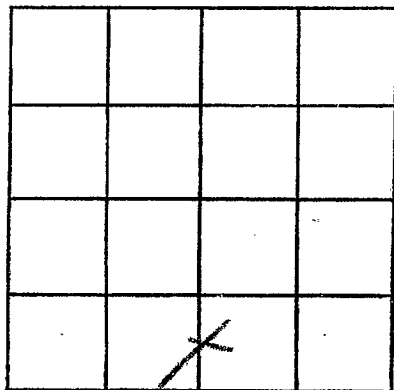

SECTION 9

Please indicate well location X.

ADDITIONAL INFORMATION

If more than one screen, show locations of each on sketch.