

CODED

MISSISSIPPI BOARD OF WATER COMMISSIONERS
416 North State Street
Jackson, Mississippi 39201

CODED

Pike
A59
9-24-68

WATER WELL DRILLERS LOG

Sept 24 68 Reensawell Pump Co. - Pike.
date well completed firm name county well located

LANDOWNER: S. H. Mettigan
RFD Summit

description of formations encountered	from	to
yellow clay	0	12
bank chalk	12	28
fine sand & gravel	28	83
coarse sand & pea gravel	83	95

(mailing address)

WELL LOCATION:
sect. 34 T. 4 N. R. 7 E
3/4 mile WNW of Summit
(distance) (direction) (nearest town)

WELL PURPOSE: same
(home, irrigation, municipal, industrial)

- WELL COMPLETION DATA:
- (1) diameter (inches) 4"
 - (2) total depth (feet) 95
 - (3) static water level (feet) 57 below top of ground.
 - (4) casing plastic, bellows (material) (depth)

CODED

- (5) screen 6' 89' (length) (depth to top)
4" plastic (size) (material)


- (6) pump old rod pump (type power)

- (7) electric log 10" (yes or no)

(organization running log)


- (8) how well bottom plugged wood chips

DRILLERS REMARKS:
old rod pump well bore

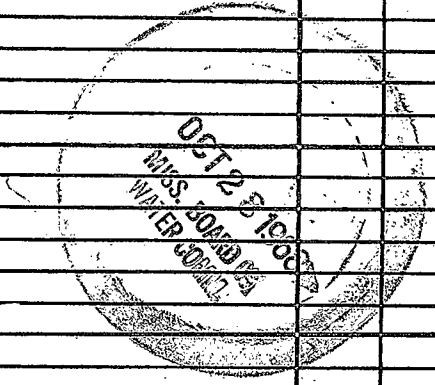

If well telescopes please sketch and show depths.

GROUND LEVEL

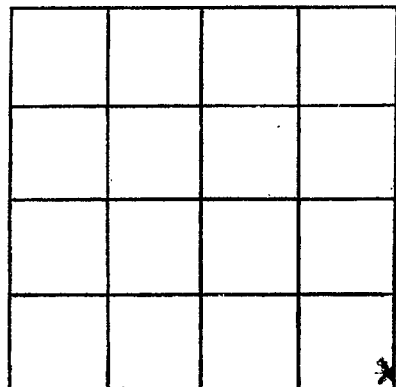

SECTION 18

Please indicate well location X.

ADDITIONAL INFORMATION

If more than one screen, show locations of each on sketch.