

CODED

Pike  
A60  
9-12-68

MISSISSIPPI  
BOARD OF WATER COMMISSIONERS  
416 North State Street  
Jackson, Mississippi 39201

CODED

WATER WELL DRILLERS LOG

Sept 12 1968 Reeves well Drilling Co. Pike  
date well completed firm name county well located

LANDOWNER: Kenneth  
Van Nostrand  
RFD Summit  
(mailing address)

description of formations encountered	from	to
yellow clay	0	12
pink chalk	12	45
small gravel sand	45	58
<del>fine sand</del>		
Red chalk	58	68
fine sand	68	85
coarse sand & pea gravel	85	93

WELL LOCATION:  
sec. 17 T. 4 N. R. 7 E  
3 miles NW of Summit  
(distance) (direction) (nearest town)

WELL PURPOSE: Home  
(home, irrigation, municipal, industrial)

WELL COMPLETION DATA:


- (1) diameter (inches) 4"
- (2) total depth (feet) 93
- (3) static water level (feet) 56 below top of ground.
- (4) casing Plastic Ballin (material) (depth)
- (size) if telescope see back.
- (5) screen 6' 87 (length) (depth to top)
- 4" Plastic (size) (material)
- (6) pump old pump by Elect (HP) (type power)
- (7) electric log No (yes or no)

CODED

(organization running log)


(8) how well bottom plugged  
washed plug.

DRILLERS REMARKS:  
New pump.

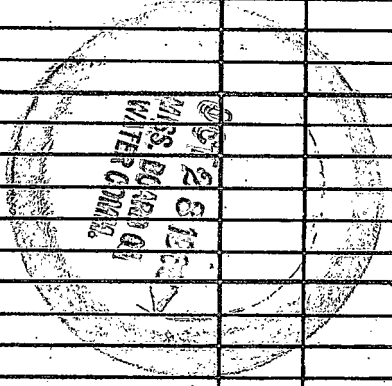

If well telescopes please sketch and show depths.

GROUND LEVEL

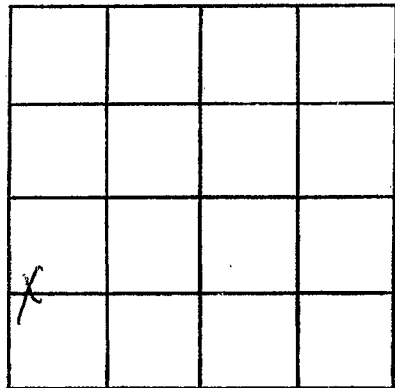

SECTION 17

Please indicate well location X.

ADDITIONAL INFORMATION

If more than one screen, show locations of each on sketch.