

Pike
A 61
10-9-68

MISSISSIPPI
 BOARD OF WATER COMMISSIONERS
 416 North State Street
 Jackson, Mississippi 39201

CODED

CODED

WATER WELL DRILLERS LOG

oct 9 1968 of Beems well pump Co. Pike
 date well completed firm name county well located

LANDOWNER: J.B. Beems

description of formations encountered

from to

M. Camb -
 (mailing address)

clay	0	3
white chalk	3	56
fine white sand	56	85
coarse sand	85	92

WELL LOCATION:

sec. 29 T 4 N R. 7 E
3 miles West of Summit
 (distance) (direction) (nearest town)

WELL PURPOSE: farm pump
 (home, irrigation, municipal, industrial)

WELL COMPLETION DATA:

CODED

- (1) diameter (inches) 4"
- (2) total depth (feet) 92
- (3) static water level (feet) 46 below above top of ground.
- (4) casing Plastic, bottom
 (material) (depth)
- (size) if telescope see back.
- (5) screen 6' 86'
 (length) (depth to top)
- 4" Plastic
 (size) (material)
- (6) pump 1/2 Sub 10
 (HP) (yield gpm)
- elect
 (type power)
- (7) electric log no
 (yes or no)

(organization running log)

(8) how well bottom plugged?
wooden plug


DRILLERS REMARKS:

DEC 16 1968

MISS. DD. OF
 WATER COMMISSIONERS

If well telescopes please sketch and show depths.

GROUND LEVEL

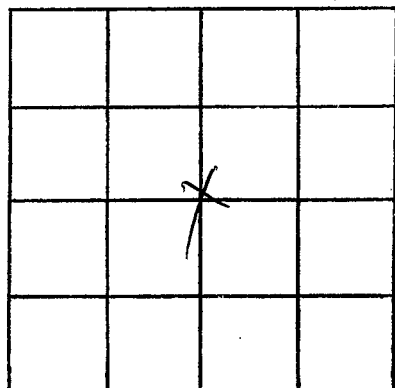

SECTION 29

Please indicate well location X.

ADDITIONAL INFORMATION

If more than one screen, show locations of each on sketch.