

CODED

MISSISSIPPI  
BOARD OF WATER COMMISSIONERS  
416 North State Street  
Jackson, Mississippi 39201

WATER WELL DRILLERS LOG

Pike  
AG2  
10-24-68

10 24 1968 Getzmond and Co Pike  
date well completed firm name county well located

LANDOWNER:

Deeb Jackson  
R.R. Summit Miss.  
(mailing address)

description of formations encountered

from

to

Red clay 0 20  
Red sand 20 40  
Coarse sand 40 80

WELL LOCATION:


sec. 23 T 4 N R 7 E  
S W  
1 miles N of Summit  
(distance) (direction) (nearest town)

WELL PURPOSE: farm  
(home, irrigation, municipal, industrial)

WELL COMPLETION DATA:


- (1) diameter (inches) 4
- (2) total depth (feet) 80
- (3) static water level (feet) 40 below above top of ground.
- (4) casing plastic 74  
(material) (depth)  
+ if telescope see back.  
(size)
- (5) screen 6 74  
(length) (depth to top)  
4 plastic  
(size) (material)
- (6) pump 1/2 12  
(HP) (yield gpm)  
Elm  
(type power)
- (7) electric log no  
(yes or no)  
(organization running log)
- (8) how well bottom plugged well

DRILLERS REMARKS:

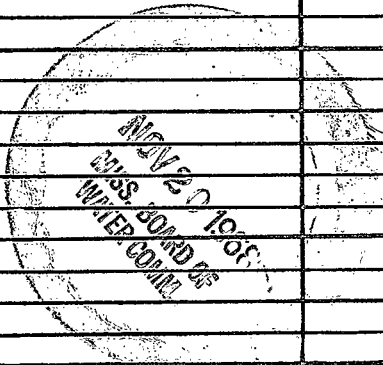

If well telescopes please sketch and show depths.

GROUND LEVEL

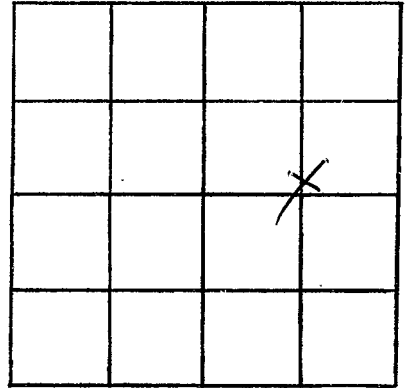

SECTION 23

Please indicate well location X.

ADDITIONAL INFORMATION

If more than one screen,  
show locations of each on sketch.