

Pike
A63
10-14-68

MISSISSIPPI
 BOARD OF WATER COMMISSIONERS
 416 North State Street
 Jackson, Mississippi 39201

CODED

WATER WELL DRILLERS LOG

10-14 1968 Fitzgerald well log Pike
 date well completed firm name county well located

LANDOWNER:

Pisgah Church Parsonage
RR. Summit Miss.
 (mailing address)

description of formations encountered

from

to

<u>Red clay</u>	<u>0</u>	<u>15</u>
<u>Red sand</u>	<u>15</u>	<u>65</u>
<u>Red gravel</u>	<u>65</u>	<u>90</u>
<u>Coarse sand & gravel</u>	<u>90</u>	<u>103</u>
		<u>15</u>
		<u>99</u>

WELL LOCATION:

sec. 32 T 4 N R 7 E
5 miles W of Summit
 (distance) (direction) (nearest town)


WELL PURPOSE: Home
 (home, irrigation, municipal, industrial)

WELL COMPLETION DATA:

- (1) diameter (inches) 4
- (2) total depth (feet) 103
- (3) static water level (feet) 75 below above top of ground.
- (4) casing Plastic 97'
 (material) (depth)
4 if telescope see back.
 (size)
- (5) screen 6" 97'
 (length) (depth to top)
6" Plastic
 (size) (material)
- (6) pump 1/2 12
 (HP) (yield gpm)
Elec
 (type power)
- (7) electric log No
 (yes or no)
 (organization running log)
- (8) how well bottom plugged wood plug


CODED

DRILLERS REMARKS:

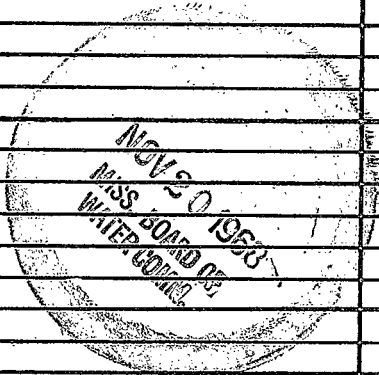

If well telescopes please sketch and show depths.

GROUND LEVEL

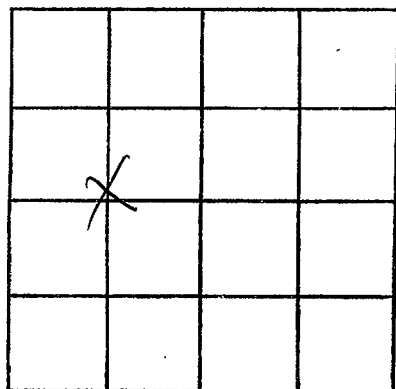

SECTION 32

Please indicate well location X.

ADDITIONAL INFORMATION

If more than one screen, show locations of each on sketch.