

MISSISSIPPI  
BOARD OF WATER COMMISSIONERS  
416 North State Street  
Jackson, Mississippi 39201

WATER WELL DRILLERS LOG

Pike  
A 6A  
11-27-68

Nov. 27 1968 O.T. Covington P. Be  
date well completed firm name county well located

LANDOWNER: Clarence Roberts

description of formations encountered

from to

Summit, Miss  
(mailing address)

Claybank  
Sand & Gravel  
0 35  
35 107

WELL LOCATION:

sec. 9 T. 24 N. R. 7 E  
S W  
4 miles North of Summit  
(distance) (direction) (nearest town)

WELL PURPOSE: Home  
(home, irrigation, municipal, industrial)

WELL COMPLETION DATA:

- (1) diameter (inches) 4"
- (2) total depth (feet) 107'
- (3) static water level (feet) 65' below above top of ground.
- (4) casing Plastic, 101' (material) (depth)

(size) If telescope see back.

- (5) screen 6' 107' (length) (depth to top)

4" Plastic (size) (material)

- (6) pump 1/2 8 (HP) (yield gpm)

A.C. (type power)

- (7) electric log (yes or no)

(organization running log)

- (8) how well bottom plugged wood

CODED


1040 732 1060 102500

MISS. DIV. OF WATER COMMISSIONERS

DRILLERS REMARKS:

If well telescopes please sketch and show depths.

GROUND LEVEL

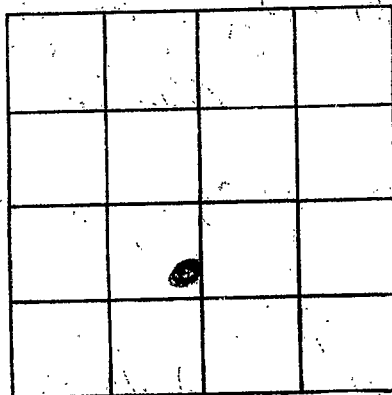

SECTION 9

Please indicate well location X.

ADDITIONAL INFORMATION

If more than one screen, show locations of each on sketch.