

CODED

MISSISSIPPI
BOARD OF WATER COMMISSIONERS
416 North State Street
Jackson, Mississippi 39201

WATER WELL DRILLERS LOG

Pike
A 65
12-5-68

Dec 5 1968 J.T. Compton Pike
date well completed firm name county well located

LANDOWNER: Martin Hart

description of formations encountered from to

Summit, Miss
(mailing address)

clay
3 and shales 0 35
35 861

WELL LOCATION:
sec. 29 T 4 N R 7 E
12 miles west of Summit
(distance) (direction) (nearest town)

WELL PURPOSE: Home
(home, irrigation, municipal, industrial)

WELL COMPLETION DATA:

- (1) diameter (inches) 4"
- (2) total depth (feet) 86'
- (3) static water level (feet) 70' below above top of ground.
- (4) casing Plastic, 80'
(material) (depth)
(size) if telescope see back.
- (5) screen 6", 86'
(length) (depth to top)
4", Plastic
(size) (material)
- (6) pump 1/2, 7
(HP) (yield gpm)
A.C.
(type power)
- (7) electric log
(yes or no)

(organization running log)
- (8) how well bottom plugged wood


CODED

DRILLERS REMARKS:

DEC 27 1968
MISS. BC. OF
WATER COMMISSIONERS

If well telescopes please sketch and show depths.

GROUND LEVEL

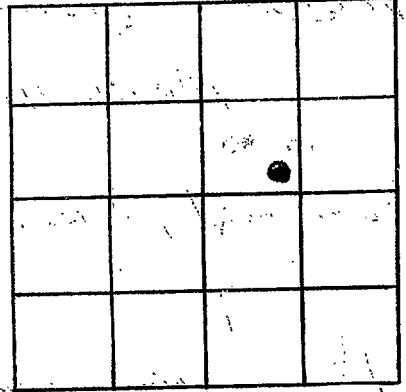

SECTION 27

Please indicate well location X.

ADDITIONAL INFORMATION

If more than one screen, show locations of each on sketch.