

CODED

MISSISSIPPI
BOARD OF WATER COMMISSIONERS
416 North State Street
Jackson, Mississippi 39201

WATER WELL DRILLERS LOG

Pike
A 66
11-2068

Nov. 25 1968 S.T. Covington Pike
date well completed firm name county well located

LANDOWNER: W. Fred Johnston

description of formations encountered

from to

Summit, Miss.
(mailing address)

CLAY
sand & rocks

0 25
25 85

WELL LOCATION:

sec. 10 T 4 N R 7 E
S W
6 miles North of Summit
(distance) (direction) (nearest town)

WELL PURPOSE: Home
(home, irrigation, municipal, industrial)

CODED

WELL COMPLETION DATA:

- (1) diameter (inches) 4"
- (2) total depth (feet) 85'
- (3) static water level (feet) 60' below above top of ground.
- (4) casing Plastic, 79'
(material) (depth)
(size) if telescope see back.
- (5) screen 6', 85'
(length) (depth to top)
4", Plastic
(size) (material)
- (6) pump 1/2, 7
(HP) (yield gpm)
D.C.
(type power)
- (7) electric log _____
(yes or no)
(organization running log)
- (8) how well bottom plugged wood


DRILLERS REMARKS:

DEC 29 1968

MISS. Bd. of
WATER COMMISSIONERS

If well telescopes please sketch and show depths.

GROUND LEVEL

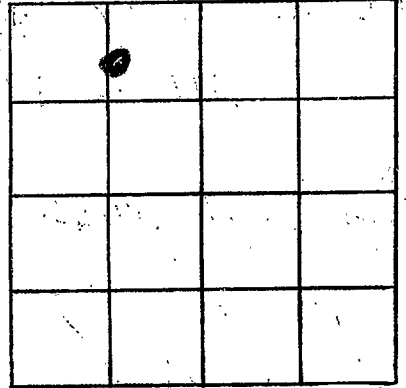

SECTION 10

Please indicate well location X.

ADDITIONAL INFORMATION

If more than one screen, show locations of each on sketch.