

**CODED**

MISSISSIPPI  
BOARD OF WATER COMMISSIONERS  
416 North State Street  
Jackson, Mississippi 39201

Pike  
A 69  
2-9-69

**WATER WELL DRILLERS LOG**

2-9 1969 Leppard Water Well Pike  
date well completed firm name county well located

LANDOWNER: Bonnie Robinson  
Rt 3 McComb Miss  
(mailing address)

description of formations encountered	from	to
<u>Red clay</u>	<u>0</u>	<u>20</u>
<u>Red sand</u>	<u>20</u>	<u>60</u>
<u>Coarse sand &amp; gravel</u>	<u>60</u>	<u>98</u>

WELL LOCATION:  
sec 26 T 4 N R 7 E  
Sm S W  
1 miles N of McComb  
(distance) (direction) (nearest town)

WELL PURPOSE: home  
(home, irrigation, municipal, industrial)

- WELL COMPLETION DATA:
- (1) diameter (inches) 4
  - (2) total depth (feet) 98
  - (3) static water level (feet) 65 below top of ground.
  - (4) casing plastic 92  
(material) (depth)  
4  
(size) If telescope see back.
  - (5) screen 6 92  
(length) (depth to top)  
4 plastic  
(size) (material)
  - (6) pump 1/2 12  
(HP) (yield gpm)  
elec  
(type power)
  - (7) electric log Yes  
(yes or no)  
(organization running log)
  - (8) how well bottom plugged used py


**CODED**

DRILLERS REMARKS:

FEB 13 1969  
MISS. BD. OF  
WATER COM.

If well telescopes please sketch and show depths.

GROUND LEVEL

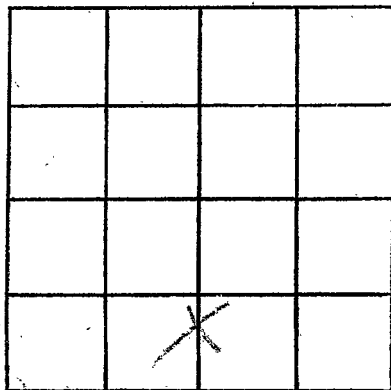

SECTION 36

Please indicate well location X.

ADDITIONAL INFORMATION

If more than one screen, show locations of each on sketch.